


STATE OF KANSAS
STATE CORPORATION COMMISSION

Give All Information Completely
Make Required Affidavit
Mail or Deliver Report to:
Conservation Division
State Corporation Commission
800 Biting Building
Wichita, Kansas

WELL PLUGGING RECORD

comp. Conn.

Rooks _____ County. Sec. 15 Twp. 9S Rge. 20W (E).....(W)
Location as "NE/CNW $\frac{1}{4}$ SW $\frac{1}{4}$ " or footage from lines NW $\frac{1}{4}$ NW $\frac{1}{4}$ NE $\frac{1}{4}$
Lease Owner Birmingham - Bartlett Drilling Co.
Lease Name Kern "D" Well No. 1
Office Address 705 Petroleum Building, Wichita 2, Kansas
Character of Well (completed as Oil, Gas or Dry Hole) Dry Hole
Date well completed November 12 1949
Application for plugging filed (verbal) November 13 1949
Application for plugging approved (verbal) November 13 1949
Plugging commenced November 14 1949
Plugging completed November 23 1949
Reason for abandonment of well or producing formation Dry Hole

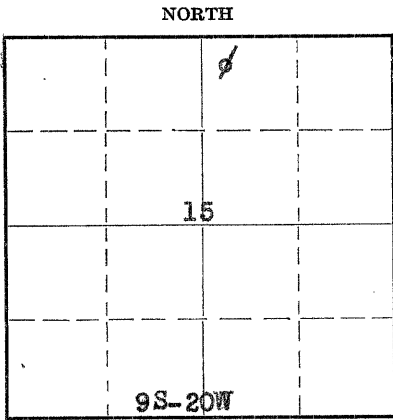

Locate well correctly on above Section Plat

If a producing well is abandoned, date of last production..... 19.....
Was permission obtained from the Conservation Division or its agents before plugging was commenced?..... Yes

Name of Conservation Agent who supervised plugging of this well Eldon Petty
Producing formation Arbuckle Depth to top 3666' Bottom 3706' Total Depth of Well 3706' Feet
Show depth and thickness of all water, oil and gas formations.

OIL, GAS OR WATER RECORDS

CASING RECORD

Formation	Content	From	To	Size	Put In	Pulled Out
				10-3/4"	191.72'	None
				5-3/2"	3677'	2974'-8"

Describe in detail the manner in which the well was plugged, indicating where the mud fluid was placed and the method or methods used in introducing it into the hole. If cement or other plugs were used, state the character of same and depth placed, from.....feet to.....feet for each plug set.

Hole filled with crushed rock from 3706' to 3660'
Dumped (bailer method) 5 sacks cement @ 3660'
Mudded hole (dump method) to 196' - set rock bridge @ 196'-185'
Dumped 20 sacks cement @ 185' - mudded hole to 35' - set rock bridge @ 35'-30'
Dumped 15 sacks @ 30' - filled to 1' in cellar

General Oil Tool Co.
By /s/ Charley C. Prater, Jr.

DEC 1 - 1949
SL 12-1-49

(If additional description is necessary, use BACK of this sheet)

Correspondence regarding this well should be addressed to Birmingham - Bartlett Drilling Co.
Address 705 Petroleum Building, Wichita 2, Kansas

STATE OF KANSAS COUNTY OF SEDGWICK ss.
Richard Hindery, partner of Birmingham-Bartlett Drilling Co. (employee of owner) or (owner or operator) of the above-described well,
being first duly sworn on oath, says: That I have knowledge of the facts, statements, and matters herein contained and the log of the above-described well as filed and that the same are true and correct. So help me God.

(Signature) Richard Hindery
705 Petroleum Building, Wichita 2, Kansas
(Address)

SUBSCRIBED AND SWORN TO before me this 30th day of November, 1949.

My commission expires Nov. 29, 1950

Vivian Z. Zinger
Notary Public.

PLUGGING
FILE SEC 15 T 9 R 20W
BOOK PAGE 126 LINE 25

KERN "D" NO. 1 WELL

LOCATION: NE¹/₄, NW¹/₄, NE¹/₄ Sec. 15-9S-20W
Rooks County, Kansas

OPERATOR: Birmingham-Bartlett Drilling Co.

CONTRACTOR: Birmingham-Bartlett Drilling Co.

DATED SPUDDED: 10-26-49

DATE COMPLETED: 11-5-49

SURFACE CASING: Ran 9 jts., 191.72' of 10-3/4" casing
cemented @ 186' with 125 sacks cement
and 1 cc.

OIL STRING: Ran 126 jts., 3677' 5 1/2" 11# J-55 casing
cemented at 3670' with 100 sacks bulk
cement.

LOG

(Figures indicate bottom of formation)

0	to	187	Clay and shale	2415	Line and shale
		890	Shale	2500	Line
		1090	Sand and shale	2865	Shale
		1140	Shale and shells	3120	Shale and lime
		1330	Sand	3195	Shale
		1655	Shale, shells & red bed	3330	Lime and shale
		1690	Anhydrite	3384	Shale
		1845	Shale	3615	Lime
		2210	Shale and shells	3673	Lime and Conglomerate
				3673	Total Depth

The undersigned Richard Hindery of the Birmingham-Bartlett Drilling Co. hereby certifies that the above is a true and correct log of the formations encountered in drilling the Kern "D" No. 1 Well as shown on the daily drilling reports.

BIRMINGHAM-BARTLETT DRILLING CO.

Richard Hindery

Subscribed and sworn before me
this 7th day of November, 1949.

Vivian J. Ginger
Notary Public

My commission expires November 29, 1950.

RECEIVED
Gulf Oil Co. D.M.I.
NOV X 9 1949
STATE CORPORATION
COMMISSION
KANSAS

15-9-20W
186-75