

15-163-01722-00-00


STATE OF KANSAS
STATE CORPORATION COMMISSION

WELL PLUGGING RECORD

Give All Information Completely
Make Required Affidavit
Mail or Deliver Report to
Conservation Division
State Corporation Comm.
245 North Water
Wichita, KS 67202

Rooks County, Sec. 18 Twp. 9S Rge. 20 XX/W
Location as "NE/CNW $\frac{1}{4}$ SW $\frac{1}{4}$ " or footage from lines
330' FSL & 330' FWL

Lease Owner Getty Oil Company
Lease Name John Towns Well No. 1
Office Address 2705 Vine, Unit #4, Hays, Kansas 67601
Character of Well (Completed as Oil, Gas or Dry Hole) Oil

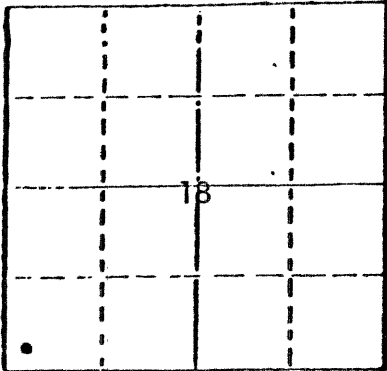

Locate well correctly on above
Section Plot

Date Well completed September 30, 1951
Application for plugging filed December 10, 1982
Application for plugging approved December 17, 1982
Plugging commenced March 14, 1983
Plugging completed March 14, 1983

Reason for abandonment of well or producing formation Well has fish & fill in hole. Remaining reserves don't justify clean-out
If a producing well is abandoned, date of last production January 11, 1982

Was permission obtained from the Conservation Division or its agents before plugging was commenced? Yes

Name of Conservation Agent who supervised plugging of this well Marion Schmidt
Producing formation Arbuckle Depth to top 3783' Bottom 3785' Total Depth of Well 3785'
Show depth and thickness of all water, oil and gas formations.

OIL, GAS OR WATER RECORDS

CASING RECORD

FORMATION	CONTENT	FROM	TO	SIZE	PUT IN	PULLED OUT
Arbuckle	Oil	3783'	3785'	8-5/8"	284	None
				5 1/2"	3813	None

Describe in detail the manner in which the well was plugged, indicating where the mud fluid was placed and the method or methods used in introducing it into the hold. If cement or other plugs were used, state the character of same and depth placed, from See Below feet to feet for each plug set.

Spotted cement plugs down 2-3/8" on tbg. as follows: 3 sx. gel w/ 25 sx. 50/50 Pozmix w/ 4% gel, 3% CaCl2 2340-2090'; 80 sx. 50/50 Pozmix, 4% gel, 3% CaCl2, 2 sx. cotton seed hulls 1765-850'; 100 sx. 50/50 Pozmix, 4% gel, 3% CaCl2, 1 sx. cotton seed hulls - no circulation. Pumped 90 sx. 50/50 Pozmix, 4% gel, 3% CaCl2, 1 sx. hulls down bradenhead & closed in @ 600#. Mixed & pumped 160 sx. 50/50 Pozmix, 4% gel, 3% CaCl2, 3 sx. hulls. Max. pressure 450#, closed in @ 300#. Cut off csg. 6' below ground level and welded plate over csg. Filled in hole.

(If additional description is necessary, use BACK of this sheet)

Name of Plugging Contractor Ostrom Well Service - Unit
Allied - Cementing

STATE OF Kansas COUNTY OF Ellis, ss.
Frank L. Renard (employee of owner) or (owner or operator)

of the above-described well, being first duly sworn on oath, says: That I have knowledge of the facts, statements, and matters herein contained and the log of the above-described well as filed and that the same are true and correct. So help me God.

(Signature) Frank Renard

(Address)

SUBSCRIBED AND SWORN to before me this 24th day of March, 1983

commission expires

NOTARY PUBLIC
STATE OF KANSAS
My Appointment Expires
September 9, 1984

Robbie Schippers
Notary Public.

RECEIVED
STATE CORPORATION COMMISSION

MAY 12 1983
5-12-83
CONSERVATION DIVISION
Wichita, Kansas

OPERATOR Getty Oil Company LEASE NAME John Towns #1 SEC. 18 TWP. 9S RGE. 20W

FILL IN WELL LOG AS REQUIRED:

Show all important zones of porosity and contents thereof; cased intervals, and all drill-stem tests, including depth interval tested, cushion used, time lost on, flooding and shut-in pressures, and recoveries.

SHOW GEOLOGICAL MARKERS, LOGS RUN, OR OTHER DESCRIPTIVE INFORMATION.

FORMATION DESCRIPTION, CONTENTS, ETC.	TOP	BOTTOM	NAME	DEPTH
Shale	290	900		
Sand and Shale	900	1270		
Shale and Shells	1270	1565		
Shale	1565	1610		
Anhydrite	1610	1650		
Shale	1650	1815		
Lime and Shale	1815	2090		
Shale and Salt	2090	2275		
Shale and Shells	2275	2370		
Lime	2370	2585		
Lime and Shale	2585	2625		
Lime	2625	2700		
Shale and Lime	2700	2790		
Lime	2790	2910		
Lime and Shale	2910	3025		
Shale	3025	3240		
Shale and Lime	3240	3340		
Lime	3340	3455		
Shale and Lime	3455	3515		
Lime	3515	3585		
Medium granular, soft Lime	3585	3598		
Lime	3598	3693		
Fine crystalline Lime	3693	3698		
Lime	3698	3705		
Fine crystalline Lime	3705	3709		
Lime	3709	3713		
Fine crystalline Lime	3713	3718		
Lime	3718	3782		
Light grey medium crystalline, pyritic dolomite	3782	3784		
Grey to brown, medium coarsely crystalline dolomite	3784	3785		