

Correction

FORM MUST BE SIGNED  
EFFECTIVE DATE: 1-03-90  
FORM C-1 12/88

State of Kansas  
NOTICE OF INTENTION TO DRILL

FORM MUST BE SIGNED  
ALL BLANKS MUST BE FILLED

Must be approved by the K.C.C. five (5) days prior to commencing well

Expected Spud Date 4-2-90  
month day year

Ap. NW CORRECTION SW SE 34. 9 S, Rg 19W East  
From Spot Location Moved 200Ft. East  
\* ..... 990 ..... feet from South line of Section  
\* ..... 2210-2110' ..... feet from East line of Section  
(Note: Locate well on Section Plat Below)

OPERATOR: License # .... 30259 .....  
Name: Werth Exploration Trust .....  
Address: P.O. Box 533 .....  
City/State/Zip: Hays, Ks. 67601 .....  
Contact Person: Andy Werth .....  
Phone: 9136254968 .....

County: Rooks .....  
Lease Name: Webster #7 Well #: .....  
Field Name: Zurich TWST South .....  
Is this a Prorated Field? .... yes  no  
Target Formation(s): Arbuckle .....  
Nearest lease or unit boundary: ..... 330

CONTRACTOR: License #: Lloyd Pfeifer Drlg. .....  
Name: # 3300 .....

\* Ground Surface Elevation: ..... 2183 ..... feet MSL  
Domestic well within 330 feet: .... yes  no  
Municipal well within one mile: .... yes  no  
Depth to bottom of fresh water: ..... 180 .....  
Depth to bottom of usable water: ..... 950 .....  
Surface Pipe by Alternate: .... 1  2  
\* Length of Surface Pipe Planned to be set: 240 .....  
Length of Conductor pipe required: ..... \*\*\*\*\*  
Projected Total Depth: ..... 3700 .....  
Formation at Total Depth: Arbuckle .....  
Water Source for Drilling Operations:  
... well  farm pond .... other

Well Drilled For: Well Class: Type Equipment:

Oil ... Inj  Infield  Mud Rotary  
... Gas ... Storage ... Pool Ext. ... Air Rotary  
... OWWO ... Disposal ... Wildcat ... Cable  
... Seismic; ... # of Holes

If OWWO: old well information as follows:  
Operator: .....  
Well Name: .....  
Comp. Date: ..... Old Total Depth .....

DWR Permit #: .....  
Will Cores Be Taken? .... yes  no  
If yes, proposed zone: .....

Directional, Deviated or Horizontal wellbore? .... yes  no  
If yes, total depth location: .....


WAS: 2310' FEL; G.L. N/A  
Csg. depth. 242'; Contractor: Unknown AFFIDAVIT

IS: 2110' FEL; G.L. 2183  
Csg. depth. 240'  
Contractor: Lloyd Drilling Co. #3300'

The undersigned hereby affirms that the drilling, completion and eventual plugging of this well will comply with K.S.A. 55-101, et. seq.

- It is agreed that the following minimum requirements will be met:
1. The appropriate district office shall be notified before setting surface pipe;
  2. The minimum amount of surface pipe as specified above shall be set by circulating cement to the top; in all cases surface pipe shall be set through all unconsolidated materials plus a minimum of 20 feet into the underlying formation;
  3. If the well is dry, a plugging proposal shall be submitted to the district office. An agreement between the operator and the district office on plug length and placement is necessary prior to plugging;
  4. The appropriate district office will be notified before well is either plugged or production casing is cemented in;
  5. If an Alternate II completion, production pipe shall be cemented from below any usable water to surface within 120 days of spud date. In all cases, notify district office prior to any cementing.

I hereby certify that the statements made herein are true and to the best of my knowledge and belief.  
Date: 3-27-90 Signature of Operator or Agent: Andy Werth Title: owner

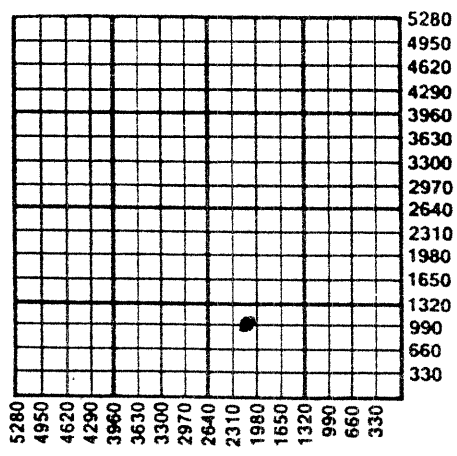

STATE OF KANSAS  
MAR 26 1990  
CONSERVATION DIVISION  
Wichita, Kansas

FOR KCC USE:  
API # 15- 163-23075-00-00  
Conductor pipe required NONE feet  
Minimum surface pipe required 200' feet per Alt.   
Approved by: DPW 12-29-89; DPW 5-25-90  
EFFECTIVE DATE: 1-03-90  
This authorization expires: 6-29-90  
(This authorization void if drilling not started within 6 months of effective date.)  
Spud date: \_\_\_\_\_ Agent: \_\_\_\_\_

34  
9  
19W

- REMEMBER TO:
- File Drill Pit Application (form CDP-1) with Intent to Drill;
  - File Completion Form ACO-1 within 120 days of spud date;
  - File acreage attribution plat according to field proration orders;
  - Notify appropriate district office 48 hours prior to workover or re-entry;
  - Submit plugging report (CP-4) after plugging is completed;
  - Obtain written approval before disposing or injecting salt water.