

CARD MUST BE TYPED

State of Kansas  
**NOTICE OF INTENTION TO DRILL**  
(see rules on reverse side)

CARD MUST BE SIGNED

Starting Date: January 25, 1985  
month day year

API Number 15- 163-01,015-00-01

OPERATOR: License # 5339  
Name Bergman Oil Company  
Address 520 Union Center Bldg.  
City/State/Zip Wichita, KS 67202  
Contact Person Harold I. Bergman  
Phone (316) 267-5291

NE.. NE.. NE Sec 13 Twp 9 S, Rge 19  East  
(location)  West  
4950' Ft North from Southeast Corner of Section  
330 Ft West from Southeast Corner of Section  
(Note: Locate well on Section Plat on reverse side)

CONTRACTOR: License # 5659  
Name Bergman Drilling, Inc.  
City/State Wichita, KS


Nearest lease or unit boundary line ..... feet.  
County Rooks  
Lease Name Hilgers SWD Well# 1

Well Drilled For: Well Class: Type Equipment:  
 Oil  Swd  Infield  Mud Rotary  
 Gas  Inj  Pool Ext.  Air Rotary  
 OWWO  Expl  Wildcat  Cable

Domestic well within 330 feet:  yes  no  
Municipal well within one mile:  yes  no

Depth to Bottom of fresh water ..... 120 feet  
Lowest usable water formation ..... Dakota  
Depth to Bottom of usable water ..... 900 feet

If OWWO: old well info as follows:  
Operator Columbia Supply Co.  
Well Name Hilgers #1  
Comp Date 8/12/46 Old Total Depth 3484'  
Projected Total Depth ..... 1500' feet  
Projected Formation at TD Cedar Hill  
Expected Producing Formations .....

Surface pipe by Alternate:  1  2  
Surface pipe ~~to be~~ set 10 3/4" @ 252' feet  
Conductor pipe if any required ..... feet  
Ground surface elevation ..... feet MSL  
This Authorization Expires 7-24-85  
Approved By 1-24-85 

I certify that we will comply with K.S.A. 55-101, et seq., plus eventually plugging hole to K.C.C. specifications.


Date 1-24-85 Signature of Operator or Agent  Title Owner

RECEIVED  
STATE CORPORATION COMMISSION

Must be filed with the K.C.C. five (5) days prior to commencing well  
This card void if drilling not started within six (6) months of date received by K.C.C.

IAN 24 1985  
1-24-85

Wichita, Kansas  
A Regular Section of Land  
1 Mile = 5,280 Ft.

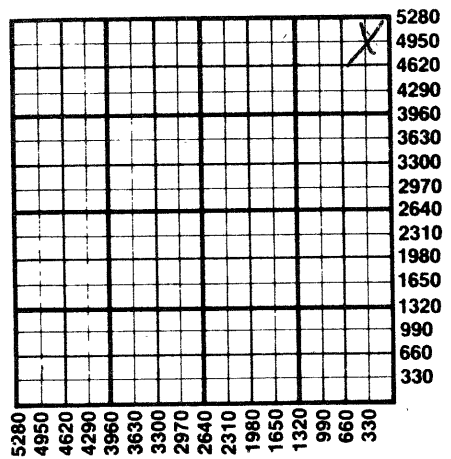

**Important procedures to follow:**

1. Notify District office before setting surface casing.
2. Set surface casing by circulating cement to the top.
3. File completion forms ACO-1 with K.C.C. within 90 days of well completion, following instructions on ACO-1, side 1, and including copies of wireline logs.
4. Notify District office 48 hours prior to old well workover or re-entry.
5. Prior to plugging, prepare a plugging plan, then obtain agreement from the appropriate district office for an approved plugging plan.
6. Submit plugging report (CP-4) to K.C.C. after plugging is completed.
7. Obtain an approved injection docket number before disposing of salt water.
8. Notify K.C.C. within 10 days when injection commences or terminates.
9. If an alternate 2 completion, cement in the production pipe from below any usable water to surface within 120 days of spud date.

State Corporation Commission of Kansas  
Conservation Division  
200 Colorado Derby Building  
Wichita, Kansas 67202  
(316) 263-3238