

CARD MUST BE TYPED

State of Kansas

CARD MUST BE SIGNED

NOTICE OF INTENTION TO DRILL

(see rules on reverse side)

Starting Date 12 15 85
month day year

API Number 15— 163-22,842-00-00

OPERATOR: License # 9067
Name DaMar Resources, Inc.
Address P. O. Box 70
City/State/Zip Hays, KS 67601
Contact Person Daniel F. Schippers
Phone (913) 625-0020

NW. SW. NE. Sec. 29. Twp. 9. S, Rg. 20. East
..... 3630 Ft. from South Line of Section
..... 2310 Ft. from East Line of Section

(Note: Locate well on Section Plat on reverse side)

CONTRACTOR: License # 5420
Name White & Ellis Drilling, Inc.
City/State Wichita, KS

Nearest lease or unit boundary line 330 feet
County Rooks

Lease Name Lambert Well # 1
Ground surface elevation 2290 est. feet MSL

Well Drilled For: Well Class: Type Equipment:
 Oil SWD Infield Mud Rotary
 Gas Inj Pool Ext. Air Rotary
 OWWO Expl Wildcat Cable

Domestic well within 330 feet: yes no
Municipal well within one mile: yes no

Surface pipe by Alternate: 1 2

If OWWO: old well info as follows:
Operator
Well Name
Comp Date Old Total Depth

Depth to bottom of fresh water 360
Depth to bottom of usable water ~1000
Surface pipe planned to be set 400
Projected Total Depth 3,900 feet
Formation Arbuckle

I certify that well will comply with K.S.A. 55-101, et seq., plus eventually plugging hole to KCC specifications.

..... cementing will be done immediately upon setting production casing.
Date 12/6/85 Signature of Operator or Agent *Daniel F. Schippers* Title President

For KCC Use:
Conductor Pipe Required feet; Minimum Surface Pipe Required feet per Alt. 2
This Authorization Expires 6-9-86 Approved By 12-9-85

real/one


RE

Must be filed with the K.C.C. five (5) days prior to commencing well
This card void if drilling not started within six (6) months of date received by K.C.C.

Important procedures to follow:

1. Notify District office before setting surface casing.
2. Set surface casing by circulating cement to the top.
3. File completion forms ACO-1 with K.C.C. within 90 days of well completion, following instructions on ACO-1, side 1, and including copies of wireline logs.
4. Notify District office 48 hours prior to old well workover or re-entry.
5. Prior to filing Intent, prepare a proposed plugging plan in case well is D & A, then obtain approval of plan when calling district office prior to setting surface pipe.
6. Submit plugging report (CP-4) to K.C.C. after plugging is completed.
7. Obtain an approved injection docket number before disposing of salt water.
8. Notify K.C.C. within 10 days when injection commences or terminates.
9. If an alternate 2 completion, cement in the production pipe from below any usable water to surface within 120 days of spud date.

A Regular Section of Land 1 Mile = 5,280 Ft.

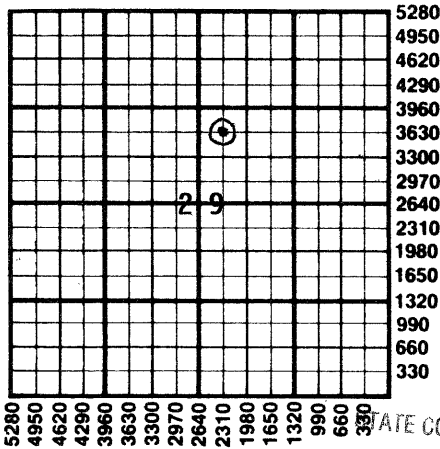

DEC 9 1985
12-9-85
CONSERVATION DIVISION
Wichita, Kansas

State Corporation Commission of Kansas
Conservation Division
200 Colorado Derby Building
Wichita, Kansas 67202
(316) 263-3238