


WELL PLUGGING RECORD

Give All Information Completely  
Make Required Affidavit  
Mail or Deliver Report to:  
Conservation Division  
State Corporation Commission  
800 Bittig Building  
Wichita, Kansas

Rooks County, Sec. 20 Twp. 9S Rge. 20 (E) (W)  
Location as "NE/CNW $\frac{1}{4}$ SW $\frac{1}{4}$ " or footage from lines SE SE SE  
Lease Owner Fred B. Anschutz  
Lease Name Kern Well No. 1  
Office Address 709 Union National Bank Bldg.  
Character of Well (completed as Oil, Gas or Dry Hole) Dry  
Date well completed 6-26 19 50  
Application for plugging filed 6-26 19 50  
Application for plugging approved 6-26 19 50  
Plugging commenced 6-26 19 50  
Plugging completed 6-26 19 50  
Reason for abandonment of well or producing formation Dry

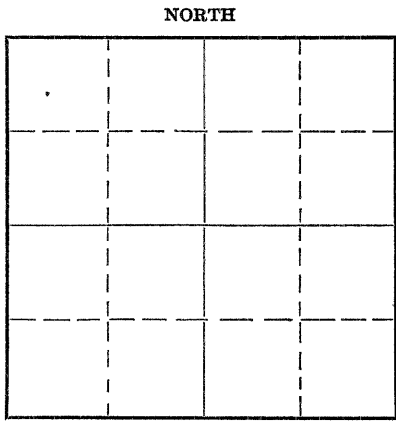

Locate well correctly on above Section Plat

If a producing well is abandoned, date of last production 19  
Was permission obtained from the Conservation Division or its agents before plugging was commenced? Yes

Name of Conservation Agent who supervised plugging of this well C.D. Stough  
Producing formation Depth to top Bottom Total Depth of Well 3940 Feet  
Show depth and thickness of all water, oil and gas formations.

OIL, GAS OR WATER RECORDS

CASING RECORD

Formation	Content	From	To	Size	Put In	Pulled Out
				8-5/8"	160'	

Describe in detail the manner in which the well was plugged, indicating where the mud fluid was placed and the method or methods used in introducing it into the hole. If cement or other plugs were used, state the character of same and depth placed, from feet to feet for each plug set.

Bottom plug set at 160' with 15 sacks cement  
Top plug set at 35' with 10 sacks cement.

RECEIVED

Conservation Div.  
7/20/50  
JUL 20 1950

STATE CORPORATION  
COMMISSION  
KANSAS

(If additional description is necessary, use BACK of this sheet)

Correspondence regarding this well should be addressed to Anschutz Drilling Company, Inc.  
Address 709 Union National Bank Bldg., Wichita, Ks.

STATE OF Kansas, COUNTY OF Sedgwick, ss.  
M. W. Smith (employee of owner) or (owner or operator) of the above-described well,  
being first duly sworn on oath, says: That I have knowledge of the facts, statements, and matters herein contained and the log of the above-described well as filed and that the same are true and correct. So help me God.

(Signature) *M. W. Smith*  
709 Union Natl Bank Bldg., Wichita  
(Address)

SUBSCRIBED AND SWORN to before me this 19th day of July, 19 50

My commission expires January 21, 1954 Patricia Meeker Notary Public.

PLUGGING  
FILE SEC 20 T 9 R 20W  
BOOK PAGE 13 LINE 45

ANSCHUTZ DRILLING COMPANY, INC.

#1 Kern - SE SE SE 20-9S-20W  
ROCKS COUNTY, KANSAS

COMMENCED: 6/15/50  
COMPLETED: 6/26/50

0	40	Topsoil & shale
40	110	Sand & shale
110	162	Shale & shells
162	675	Blue shale
675	1340	Shale & shells
1340	1805	Shale & shells
1805	1810	Anhydrite
1810	1835	Anhydrite
1835	1975	Shale & shells
1975	2240	Shale & shells
2240	2415	Lime & shale
2415	2480	Shale & shells
2480	2510	Shale
2510	2550	Shale & lime
2550	2650	Shale & lime
2650	2770	Shale & lime
2770	2860	Shale & lime
2860	2960	Shale & lime
2960	3085	Lime & shale
3085	3170	Shale
3170	3240	Shale & lime
3240	3335	Lime & shale
3335	3415	Lime & shale
3415	3495	Shale & lime
3495	3580	Lime & shale
3580	3615	Shale & lime
3615	3655	Lime
3655	3710	Lime
3710	3750	Lime
3750	3788	Lime
3788	3795	Lime
3795	3865	Lime
3865	3904	Lime
3904	3940	Lime
3940		Rotary Total Depth

CASING RECORD

3-5/8" surface casing at  
160' with 90 sacks cement.

STATE OF KANSAS )  
COUNTY OF SEDGWICK )

I hereby affirm that the above and foregoing is a true and correct copy of the log of the #1 Kern located in the SE SE SE of Section 20-9S-20W, Rooks County, Kansas.

ANSCHUTZ DRILLING COMPANY, INC.

BY: *M. W. Smith*

M. W. Smith

Subscribed and sworn to before me this 19th day of July, 1950.

*Leticia Becker*

Notary Public

My commission expires  
January 21, 1954.

PLUGGING  
FILE SEC 20 T 9 R 20W  
BOOK PAGE 13 LINE 45