

STATE OF KANSAS  
STATE CORPORATION COMMISSION


WELL PLUGGING RECORD

Give All Information Completely  
Make Required Affidavit  
Mail or Deliver Report to:  
Conservation Division  
State Corporation Commission  
800 Bitting Building  
Wichita, Kansas

OR  
FORMATION PLUGGING RECORD

Strike out upper line  
when reporting plugging  
off formations.

NORTH

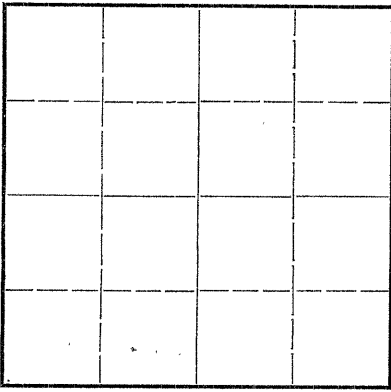

Locate well correctly on above  
Section Flat

Rocks..... County. Sec. 20 Twp. 9-S Rge. ~~20~~ 20 (W)  
Location as "NE¼NW¼SW¼" or footage from lines. NW NW NW  
Lease Owner. The Palmer Oil Corporation  
Lease Name. Neil Well No. 1  
Office Address. 415 Union Nat'l Bank Bldg., Wichita, Kansas  
Character of Well (completed as Oil, Gas or Dry Hole)..... Dry Hole  
Date well completed. 5/27/47 19  
Application for plugging filed. 5/30/47 19  
Application for plugging approved. 5/30/47 19  
Plugging commenced. 6/2/47 19  
Plugging completed. 6/10/47 19  
Reason for abandonment of well or producing formation. Dry Hole

If a producing well is abandoned, date of last production..... 19  
Was permission obtained from the Conservation Division or its agents before plugging was commenced? Yes

Name of Conservation Agent who supervised plugging of this well. C. D. Stough, Hays, Kansas  
Producing formation..... Depth to top..... Bottom..... Total Depth of Well. 3886 Feet  
Show depth and thickness of all water, oil and gas formations.

OIL, GAS OR WATER RECORDS

CASING RECORD

Formation	Content	From	To	Size	Put In	Pulled Out
				8 5/8	185	None
				5 1/2	3861	1050

Describe in detail the manner in which the well was plugged, indicating where the mud fluid was placed and the method or methods used in introducing it into the hold. If cement or other plugs were used, state the character of same and depth placed, from.....feet to.....feet for each plug set.

3886 - 3856 10 sacks cement dumped on bottom  
3856 - 200 Heavy mud  
200 Wooden plug & bridge  
200 - 140 20 sacks cement  
140 - 30 Heavy mud  
30 Wood plug  
30 - bottom of celler - 10 sax cement

(If additional description is necessary, use BACK of this sheet)


Correspondence regarding this well should be addressed to. The Palmer Oil Corporation  
Address. 415 Union National Bank Bldg., Wichita 2, Kansas

STATE OF Kansas, COUNTY OF Sedgwick, ss.  
J. P. McKee (employee of owner) or (owner or operator) of the above-described well,  
being first duly sworn on oath, says: That I have knowledge of the facts, statements, and matters herein contained and the log of the above-described well as filed and that the same are true and correct. So help me God.

(Signature) J. P. McKee Geologist  
415 Union Nat'l Bank Bldg., Wichita 2, Kansas  
(Address)

SUBSCRIBED AND SWORN TO before me this 14th day of June 1947  
Notary Public.

My commission expires 3/21/49

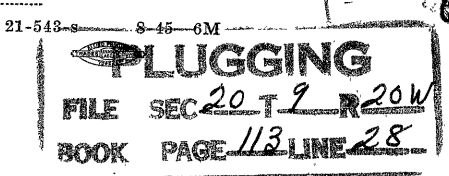

WELL LOG - WELL NO. 1

Well Owner - The Palmer Oil Corporation  
 Contractor - The Palmer Oil Corporation

Sec. 20-9S-20W  
 Location: NW 1/4 NW  
 County: Rooks County, Kansas  
 Elevation: 2293  
 L. P. - Dry  
 Casing: 8 5/8" - 185' over 100' max  
 5 1/2" - 3861' over 20' max

Commenced - 3/23/47  
 Completed - 5/26/47

Total Depth: 3886

Callar	0	6
City	6	40
Sand & Shale	40	185
Shale & Shells	185	900
Shale & Sandy Shells	900	1250
Sand & White Shells	1250	1510
Shale & Shells	1510	1525
Red bed - shale - shells	1525	1730
Shale & Shells	1730	1790
Anhydrite	1790	1837
Shale & Shells	1837	2140
Broken Lime & Shale	2140	2330
Lime & Shale	2330	2425
Broken lime & shale	2425	2515
Line	2515	2560
Shale & shells	2560	2575
Broken lime & shale	2575	2665
Line & Shale	2665	3000
Line	3000	3060
Line & shale	3060	3170
Shale & shells	3170	3270
Line & Shale	3270	3475
Line	3475	3530
Line & Shale	3530	3583
Line	3583	3814
Line & Shale	3814	3860
Line	3860	3886
Total Depth		3886

FORMATION TOPS:

Anhydrite	1790
Lansing	3569
Base Kansas City	3790
Conglomerate	3844
Si. ss	3846
Arbuckle	3860

TESTING DATA:

- 3864 Rainbow show oil
- 3866 dump 10 gal Acid, sat 2 hrs - very small show free oil
- 3872 Bailed & tested 10 hrs - one boiler wtr and 1 gal Oil per hr
- 3883 Filled 350 feet with wtr in 1 1/2 hrs
- 3886 No apparent increase in water

I hereby certify that this is a true and correct log of the above-mentioned well.

THE PALMER OIL CORPORATION

*J. P. McKee*  
 J. P. McKee

STATE OF KANSAS )  
 COUNTY OF SEDGWICK ) SS

Subscribed and sworn to Before me, a Notary Public in said County and State, this 1th day of June, 1947.

PLUGGING

My commission expires 3/21/49.

FILE SEC 20 9 20W  
 BOOK PAGE 113 LINE 28

Public