

Give All Information Completely  
Make Required Affidavit  
Mail or Deliver Report to:  
Conservation Division  
State Corporation Commission  
212 North Market, Insurance Bldg.  
Wichita, Kansas

WELL PLUGGING RECORD

Rooks County, Sec. 20 Twp. 9 Rge. (E) 20 (W)

Location as "NE/CNW%SW%" or footage from lines CNL NE NE

Lease Owner Frank J. Black

Lease Name Neil #1 Well No. 1

Office Address Box 150, McPherson, Kansas

Character of Well (completed as Oil, Gas or Dry Hole) Oil

Date well completed 10-10-45 19

Application for plugging filed 12-30-60 19

Application for plugging approved 1-3-61 19


Plugging commenced 1-7 19 61

Plugging completed 3-24 19 61

Reason for abandonment of well or producing formation Non-commercial

If a producing well is abandoned, date of last production 19

Was permission obtained from the Conservation Division or its agents before plugging was commenced? Yes

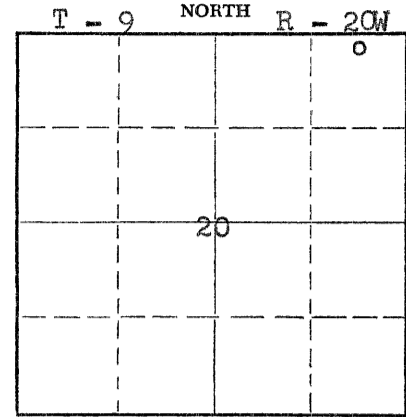

Locate well correctly on above Section Plat

Name of Conservation Agent who supervised plugging of this well Eldon Petty

Producing formation \_\_\_\_\_ Depth to top \_\_\_\_\_ Bottom \_\_\_\_\_ Total Depth of Well 3865' Feet

Show depth and thickness of all water, oil and gas formations.

OIL, GAS OR WATER RECORDS

CASING RECORD

FORMATION	CONTENT	FROM	TO	SIZE	PUT IN	PULLED OUT
				10"	208'	None
				5 1/2"	3849'	977'

Describe in detail the manner in which the well was plugged, indicating where the mud fluid was placed and the method or methods used in introducing it into the hole. If cement or other plugs were used, state the character of same and depth placed, from \_\_\_\_\_ feet to \_\_\_\_\_ feet for each plug set.

Sanded hole to 3830' - dumped 4 sks cement - pulled pipe to 550' - Pumped in 20sks mud and 20sks cement - pulled pipe to 150' - pumped in 20 sks cement - pulled rest of pipe - mudded hole to 30' - set 10' rock bridge - dumped 10 sks cement

RECEIVED  
STATE CORPORATION COMMISSION  
5/1/61  
MAY 1 1961

CONSERVATION DIVISION  
Wichita, Kansas

(If additional description is necessary, use BACK of this sheet)

Name of Plugging Contractor R & D Casing Pulling Co License #236

Address Box #572, Hutchinson, Kansas

STATE OF KANSAS, COUNTY OF MCPHERSON, ss. Frank J. Black (employee of owner) or (owner or operator)

well, being first duly sworn on oath, says: That I have knowledge of the facts, statements, and matters herein contained and the log of the above-described well as filed and that the same are true and correct. So help me God.

(Signature) \_\_\_\_\_ (Address) \_\_\_\_\_

SUBSCRIBED AND SWORN TO before me this 29th day of April, 1961

My commission expires July 16, 1963

Jerry Peltzman  
JERRY PELTZMAN Notary Public.

WELL LOG BUREAU KANSAS GEOLOGICAL SOCIETY  
412 Union National Bk Bldg., Wichita, Kansas

**COPY**

Company  
Farm Neil

G.W. KEYES DRIG. CO.  
No. 1.


SEC. 20 T. 9 R. 20 W  
CNI NE NE

DISCOVERY WELL

Total Depth. 3865  
Comm. 8-17-45  
Shot or Treated.  
Contractor.  
issued. 2-23-46

Comp. 10-10-45

County. Rocks.  
KANSAS

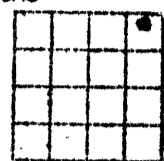

CASING:  
10 3/4" 208'  
5 1/2" 3849'

Elevation. \_\_\_\_\_

Production. Phy.Pot. 211 B plus  
5% Wtr.

Figures Indicate Bottom of Formations.

- clay, sand, shale & shells 150
- shale & shells 750
- sand 975
- shale & shells 1270
- sand 1475
- sand & shale 1655
- shale 1740
- anhydrite 1770
- lime & shale 1850
- shale & shells 2305
- lime 2325
- shale 2500
- shale & lime 2585
- lime 2640
- shale & lime 2920
- lime 2970
- lime & shale 3040
- shale & shells 3150
- lime 3305
- shale & lime 3360
- lime 3490
- shale 3535
- lime 3735
- shale 3785
- shale & chert 3815
- lime & shale 3829
- conglomerate 3836
- Simpson 3847
- lime Rotary T.D. 3865

CABLE TOOL WORK  
Bailed hole dry,  
drilled cement to  
3865, washed hole  
down, hole began to  
fill w/heavy oil.  
Acidized, ran rods  
& tbg to take pmg.  
test. Well made 22BO  
in 8 hrs. Dismantled  
tools 3865

Total Depth Cable

- Tops:
- Heebner 3494
  - Lansing 3534
  - Marmaton 3831
  - Conglomerate 3829
  - Simpson 3836
  - Arbuckle 3847

WICHITA DIVISION  
WICHITA, KANSAS