


Give All Information Completely  
Make Required Affidavit  
Mail or Deliver Report to:  
Conservation Division  
State Corporation Commission  
212 No. Market  
Wichita, Kansas

WELL PLUGGING RECORD

Rooks County, Sec. 19 Twp. 9S Rge. 20 (E) W (W)  
Location as "NE/CNW%SW%" or footage from lines 330' S & 330' W SW/4  
Lease Owner Sinclair Oil & Gas Company  
Lease Name Copeland Well No. 1  
Office Address Great Bend, Kansas  
Character of Well (completed as Oil, Gas or Dry Hole) OIL  
Date well completed DECEMBER 9, 1948  
Application for plugging filed SEPTEMBER 28, 1966  
Application for plugging approved SEPTEMBER 29, 1966  
Plugging commenced 10-27-66 19  
Plugging completed 10-31-66 19  
Reason for abandonment of well or producing formation: Depleted.

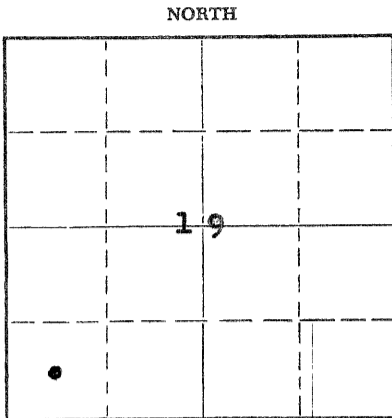

Locate well correctly on above Section Plat

If a producing well is abandoned, date of last production JULY, 1965  
Was permission obtained from the Conservation Division or its agents before plugging was commenced? yes

Name of Conservation Agent who supervised plugging of this well Leo Massey  
Producing formation \_\_\_\_\_ Depth to top \_\_\_\_\_ Bottom \_\_\_\_\_ Total Depth of Well 3899 Feet  
Show depth and thickness of all water, oil and gas formations.


OIL, GAS OR WATER RECORDS

CASING RECORD

FORMATION	CONTENT	FROM	TO	SIZE	PUT IN	PULLED OUT
				8-5/8"	1740'	None
				5-1/2"	3900'	2706'

Describe in detail the manner in which the well was plugged, indicating where the mud fluid was placed and the method or methods used in introducing it into the hole. If cement or other plugs were used, state the character of same and depth placed, from \_\_\_\_\_ feet to \_\_\_\_\_ feet for each plug set.

Checked hole to plug back @ 3790', pushed plug to 3500', sanded to 3470' and dumped 5 sacks of cement @ 3470' with dump bailer. Pulled 5 1/2 casing, set rock bridge @ 400' and filled hole with 6 yards of ready mix cement.

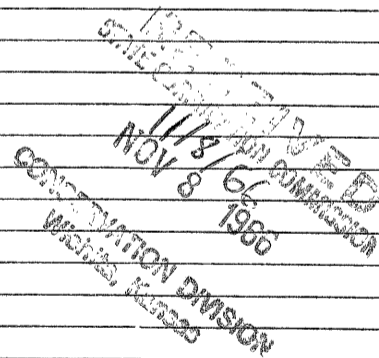

PLUGGING COMPLETE.

(If additional description is necessary, use BACK of this sheet)  
Name of Plugging Contractor KNIGHT CASING PULLING COMPANY  
Address CHASE, KANSAS

STATE OF KANSAS, COUNTY OF RICE, ss.  
Noel J. Knight (employee of owner) or (~~owner or operator~~) of the above-described well, being first duly sworn on oath, says: That I have knowledge of the facts, statements, and matters herein contained and the log of the above-described well as filed and that the same are true and correct. So help me God.

(Signature) Noel J. Knight  
Chase, Kansas  
(Address)

SUBSCRIBED AND SWORN TO before me this 4th day of November, 1966

My commission expires May 20, 1968

Milton J. Volin  
Notary Public.



