

STATE OF KANSAS
STATE CORPORATION COMMISSION

WELL PLUGGING RECORD

OR

FORMATION PLUGGING RECORD


Strike out upper line when reporting plugging of formations.

Give All Information Completely
Make Required Affidavit
Mail or Deliver Report to:
Conservation Division
State Corporation Commission,
800 Bitting Building,
Wichita, Kansas

Rooks County. Sec. 19 Twp. 9 Rge. 20 (E) (W)

Location as "NE 1/4 NW 1/4 SW 1/4" or footage from lines NE 1/4

NORTH

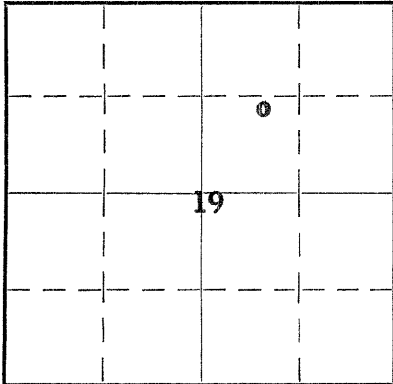

Locate well correctly on above Section Plat

Lease Owner.....

Lease Name **Balthazor** Well No. **A 1**

Office Address **P.O. Box 937 Wichita, Kansas**

Character of Well (Completed as Oil, Gas or Dry Hole) **Dry Hole**

Date, well completed **February 3, 1958** 19.....

Application for plugging filed **February 4, 1958** 193.....

Application for plugging approved **February 5, 1958** 193.....

Plugging Commenced **February 5, 1958** 193.....

Plugging Completed **February 5, 1958** 193.....

Reason for abandonment of well or producing formation **Dry Hole**

If a producing well is abandoned, date of last production..... 193.....

Was permission obtained from the Conservation Division or its agents before plugging was commenced? **Yes**

Name of Conservation Agent who supervised plugging of this well **Eldon Pattie, Hays Kansas**

Producing formation..... Depth to top..... Bottom..... Total Depth of Well **3885** Feet

Show depth and thickness of all water, oil and gas formations.

OIL, GAS OR WATER RECORDS

CASING RECORD

Formation	Content	From	To	Size	Put In	Pulled Out
Surface		Top	209'	8 5/8	209' 293	None

Describe in detail the manner in which the well was plugged, indicating where the mud fluid was placed and the method or methods used in introducing it into the hole. If cement or other plugs were used, state the character of same and depth placed, from..... feet to..... feet for each plug set.


Filled hole w/ heavy mud

Set Hal. plug at 600' w/ drill pipe 20 skd cement

Set Hal. plug at 185' w/ drill pipe 15 sks cement

Set Hal. plug at 40' w/ drill pipe 10 sks cement

Cemented top of surface pipe in cellar

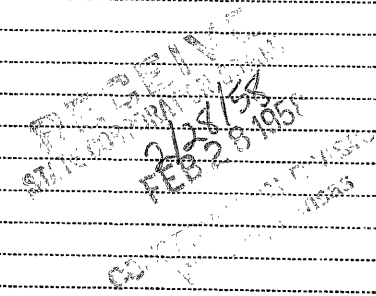

(If additional description is necessary use BACK of this sheet)

Correspondence regarding this well should be addressed to **Wentworth Oil & Development Co., Inc**
Address **Box 937 Wichita, Kansas**

STATE OF **Kansas**, COUNTY OF **Sedgwick**, ss.

Leo V. Wentworth (Employee or owner) or (owner or operator) of the above-described well, being first duly sworn on oath, says: That I have knowledge of the facts, statements, and matters herein contained and the log of the above-described well as filed and that the same are true and correct. So help me God.

(Signature) *Leo V. Wentworth*

P.O. Box 937 Wichita, Kansas
(Address)

SUBSCRIBED AND SWORN to before me this **26th** day of **February**, 19 **58**

My Commission Expires **Jan. 29, 1962**

My commission expires ~~XXXXXX~~

16-1484

11-35-5M

Loretta Adennis

Notary Public.

