

STATE OF KANSAS
STATE CORPORATION COMMISSION

WELL PLUGGING RECORD

Give All Information Completely
Make Required Affidavit
Mail or Deliver Report to:
Conservation Division
State Corporation Commission
800 Bittling Building
Wichita, Kansas

Reeks

County. Sec. 19 Twp. 9S Rge. (E) 20 (W)

Location as "NE/CNW/SW" or footage from lines NW 1/4 of SE 1/4 of NE 1/4

Lease Owner Amerada Petroleum Corp.

Lease Name J. L. Balthazer Well No. 4

Office Address Box 2040, Tulsa, Okla.

Character of Well (completed as Oil, Gas or Dry Hole) Dry Hole

Date well completed March 30, 19 53

Application for plugging filed March 30, 19 53

Application for plugging approved March 30, 19 53


Plugging commenced March 30, 19 53

Plugging completed March 30, 19 53

Reason for abandonment of well or producing formation Dry Hole

If a producing well is abandoned, date of last production _____ 19 _____

Was permission obtained from the Conservation Division or its agents before plugging was commenced? Yes

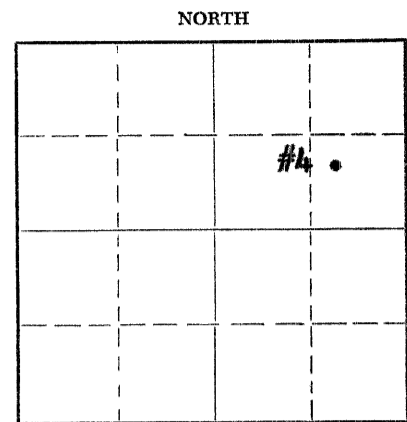

Locate well correctly on above
Section Plat

Name of Conservation Agent who supervised plugging of this well Eldon Petty of Hays, Kansas

Producing formation _____ Depth to top _____ Bottom _____ Total Depth of Well 3945' Feet

Show depth and thickness of all water, oil and gas formations.

OIL, GAS OR WATER RECORDS

CASING RECORD

FORMATION	CONTENT	FROM	TO	SIZE	PUT IN	PULLED OUT
				<u>8-5/8"</u>	<u>206'</u>	<u>None.</u>

Describe in detail the manner in which the well was plugged, indicating where the mud fluid was placed and the method or methods used in introducing it into the hole. If cement or other plugs were used, state the character of same and depth placed, from _____ feet to _____ feet for each plug set.

Filled hole with heavy mud up to 200' from top, set Halliburton Plug at 200' down from top with 1/2 sack of cotton seed hulls on top of plug, mixed & dumped in 15 sacks of regular cement, filled hole with heavy mud up to 40' down from top, set Halliburton Plug at 40' down from top with 1/2 sack of cotton seed hulls on top of plug, mixed and dumped in 10 sacks of regular cement filling hole to top of 8-5/8" OD Surface Casing in bottom of cellar as required by State Pluggger Mr. Eldon Petty of Hays, Kansas. Well Plugged and abandoned at 6:15 P.M. 3/30/53.

(If additional description is necessary, use BACK of this sheet)

Name of Plugging Contractor Peel Bros. Inc.
Address Heisington, Kansas

STATE OF Oklahoma COUNTY OF Tulsa, ss.

C. N. Rose (employee of owner) or (owner or operator) of the above-described well, being first duly sworn on oath, says: That I have knowledge of the facts, statements, and matters herein contained and the log of the above-described well as filed and that the same are true and correct. So help me God.

(Signature) [Signature]

(Address)

SUBSCRIBED AND SWORN TO before me this 3rd day of April, 1953

My commission expires January 17, 1955

Notary Public.

PLUGGING
FILE SEC 19 T 9 R 20W
BOOK PAGE 88 LINE 39

RECEIVED
STATE CORPORATION COMMISSION
4/7/53
APR 7 - 1953
CONSERVATION DIVISION
Wichita, Kansas

15-163-02372-00-00

WELL LOG

Well No. 4
 Farm J. L. Balthazor
 Elevation 2278' D.F.
 Location NW/4 SE/4 NE/4
 990' West of East line
 1650' South of North line
 Section 19-9S-20W
 Rooks County, Kansas
 Company Amerada Petroleum Corporation
 Commenced Drlg. 3-18-53
 Completed Drlg. 3-30-53
 Contractor Peel Bros., Inc.
 Initial Production Dry Hole


CASING RECORD:	<u>SIZE</u>	<u>WEIGHT</u>	<u>FEET</u>	<u>CEMENT</u>
	8-5/8"	24#	206	200 sacks

FORMATION:

Sand & Shale	0	1280'
Sand	1280	1500
Shale	1500	1620
Shale & Sand	1620	1785
Anhydrite	1785	1825
Red Bed & Shale	1825	2020
Shale & Shells	2020	2600
Shale & Lime Streaks	2600	2700
Shale & Lime Shells	2700	2790
Shale & Lime Streaks	2790	2797
Shale & Lime	2797	3415
Lime	3415	3546'
Lime & Shale	3546	3565
Lime	3565	3615
Lime & Shale	3615	3668
Lime	3668	3788
Lime & Conglomerate	3788	3820
Lime	3820	3902
Chert	3902	3924
Chert & Dolomite	3924	3945
TOTAL DEPTH		3945'

FORMATION TOPS:	<u>GEOLOGICAL</u>	<u>SCHLUMBERGER</u>
Anhydrite	1785'	1785'
Heebner	3526'	3526'
Toront		3552'
Lansing	3567'	3567'
Conglomerate	3844'	
Arbuckle	3880'	

Rotary tools used from 0 3945'

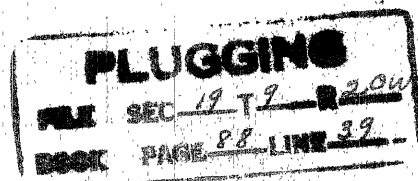

AMERADA PETROLEUM CORPORATION
TULSA, OKLAHOMA

VOUCHER NO. _____

Assessment for plugging J. L. Balthazor well No. 1,
located SW SW NE, Section 19-9S-20W, Rooks County,
Kansas

\$25.00

CHECK N^o 78905

APPROVED _____

ZAG