

15-163-00174-00-00


STATE OF KANSAS
STATE CORPORATION COMMISSION

WELL PLUGGING RECORD

Give All Information Completely
Make Required Affidavit
Mail or Deliver Report to:
Conservation Division
State Corporation Commission
800 Bittling Building
Wichita, Kansas

Rooks County, Sec. 19 Twp. 9S Rge. 20W 15E

Location as "NE/CNW 1/4 SW 1/4" or footage from lines SW 1/4 of SW 1/4 of NE 1/4
Lease Owner Amerada Petroleum Corp.
Lease Name J.L. Balthazor Well No. #1
Office Address Box 2040, Tulsa, Oklahoma
Character of Well (completed as Oil, Gas or Dry Hole) Dry Hole.
Date well completed May 20, 19 49
Application for plugging filed 19
Application for plugging approved 19
Plugging commenced May 20, 19 49
Plugging completed May 21, 19 49
Reason for abandonment of well or producing formation

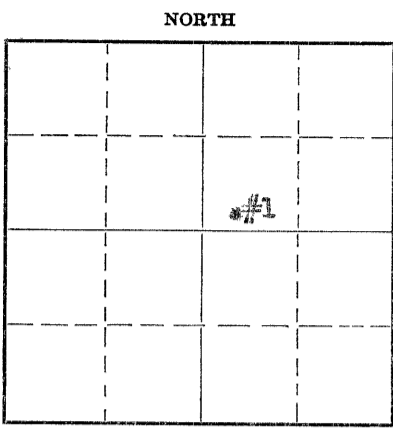

Locate well correctly on above Section Plat

If a producing well is abandoned, date of last production 19
Was permission obtained from the Conservation Division or its agents before plugging was commenced? Yes

Name of Conservation Agent who supervised plugging of this well C. D. Stough, Great Bend, Kansas.
Producing formation Depth to top Bottom Total Depth of Well 4130' Feet
Show depth and thickness of all water, oil and gas formations.

OIL, GAS OR WATER RECORDS

CASING RECORD

Formation	Content	From	To	Size	Put In	Pulled Out
				8-5/8"	258'	None

Describe in detail the manner in which the well was plugged, indicating where the mud fluid was placed and the method or methods used in introducing it into the hole. If cement or other plugs were used, state the character of same and depth placed, from feet to feet for each plug set.

Circulated Heavy Mud in Hole. Set Halliburton Plug at 250' down from top, mixed and poured in 15 sacks of regular cement through 4 1/2" drill pipe. Filled hole with heavy mud up to within 30' of top, set Halliburton Plug, dumped in 10 sacks of regular cement filling hole to top of surface casing in bottom of cellar as required by State Plugger, C.D. Stough, Great Bend, Kansas. Well Plugged and Abandoned.

RECEIVED
JUN 17 1949
CONSERVATION DIVISION

(If additional description is necessary, use BACK of this sheet)

Correspondence regarding this well should be addressed to Amerada Petroleum Corp.
Address Box 2040
Tulsa, Okla.

STATE OF Oklahoma COUNTY OF Tulsa, ss.
C. N. Rose (employee of owner) or (owner or operator) of the above-described well,
being first duly sworn on oath, says: That I have knowledge of the facts, statements, and matters herein contained and the log of the above-described well as filed and that the same are true and correct. So help me God.

(Signature) [Signature]
Box 687 Great Bend, Kas (Address)

SUBSCRIBED AND SWORN to before me this 15 day of June, 19 49

My commission expires January 17, 1951

Notary Public.

22-5133-s 9-48-10M

PLUGGING
FILE SEC-19 T-9 R-20w
PAGE 97 LINE 45

15-163-2074-00-06

Well No. 1
 Farm J. L. Balthazor
 Elevation 2302' - Derrick Floor
 Location 330' from South line
 330' from West line
 Section 19-9S-20W
 Rooks County, Kansas
 Company Amerada Petroleum Corporation
 Commenced Drlg. 5-4-49
 Completed Drlg. 5-20-49
 Contractor: Glenn W. Peel
 Initial Production None
 No time log or electric log made.

CASING RECORD:	SIZE	WEIGHT	FEET	CEMENT	PERFORATIONS
	8-5/8"	32#	258	200 Sx	None

FORMATION

Surface Clay	0	50
Sand	50	70
Shale	70	675
Sand	675	700
Shale & Sand	700	1160
Shale & Shells	1160	1195
Sand	1195	1220
Shale & Sand	1220	1565
Shale & Shells	1565	1820
Anhydrite	1820	1857
Shale & Shells	1857	2085
Broken Lime & Shale	2085	2260
Lime & Shale	2260	2385
Lime	2385	2472
Shale & Lime	2472	2565
Lime	2565	2705
Lime & Shale	2705	2975
Lime	2975	3031
Lime & Shale	3031	3225
Lime	3225	3865
Lime & Shale	2865	2885
Cherty Lime	3885	4095
Lime	4095	4130

TOTAL DEPTH: 4130'

GEOLOGICAL TOPS

Topeka	3315'
Heebner	3535'
Lansing	3572'
Conglomerate	3862'
Simpson	3984'
Arbuckle	4039'

Rotary tools used from 0' 4130'

Cable tools used from None used

RECEIVED

AMERADA PETROLEUM CORPORATION

MAY 27 1949

SECTION 19-9S-20W

ROOKS COUNTY, KANSAS


PLUGGING
 FILE SEC 19 T 9 R 20W
 BOOK PAGE 97 LINE 45

STATE OF KANSAS

15-163-00174-00-00

INVOICE

May 23, 1949

To: Amerada Petroleum Corp.
Box 2040
Tulsa, Oklahoma

STATE CORPORATION COMMISSION
CONSERVATION DIVISION
800 BITTING BUILDING
WICHITA, KANSAS

FOR: PLUGGING ASSESSMENT AS FOLLOWS:

J. L. Balthazor Well No. #1
CSW SW NE 19-9-20W
File No. 97-45

\$25.00

NOTE: We also need a Written Application, a Well Log and a Well Plugging Record on this well to complete our file.

#79905
Jan
5-31-49
GWS

RETURN THIS COPY WITH REMITTANCE

AMERADA PETROLEUM CORPORATION
TULSA, OKLAHOMA

VOUCHER NO. Apr.

Assessment for plugging J. L. Balthazor Well #4, located NW/4 SE/4
NE/4, Section 19-9S-20W, Rooks County, Kansas \$25.00

CHECK N° A 61482

APPROVED  _____