

STATE OF KANSAS
STATE CORPORATION COMMISSION


WELL PLUGGING RECORD

OR
FORMATION PLUGGING RECORD

Strike out upper line
when reporting plug-
ging off formations.

Give All Information Completely
Make Required Affidavit
Mail or Deliver Report to:
Conservation Division
State Corporation Commission
800 Bittig Building
Wichita, Kansas

Rooks County. Sec. 26 Twp. 9S Rge. (E) 20 (W)
Location as "NE 1/4 NW 1/4 SW 1/4" or footage from lines SW/corner of NE 1/4
Lease Owner Virginia Drilling Company, Inc. and I. O. Miller
Lease Name Steeples Well No. 1
Office Address 701 Brown Building, Wichita 2, Kansas
Character of Well (completed as Oil, Gas or Dry Hole) Dry Hole
Date well completed July 6, 1948
Application for plugging filed July 7, 1948
Application for plugging approved July 7, 1948
Plugging commenced July 20, 1948
Plugging completed July 21, 1948
Reason for abandonment of well or producing formation Dry hole
If a producing well is abandoned, date of last production 19
Was permission obtained from the Conservation Division or its agents before plugging was com-
menced? yes

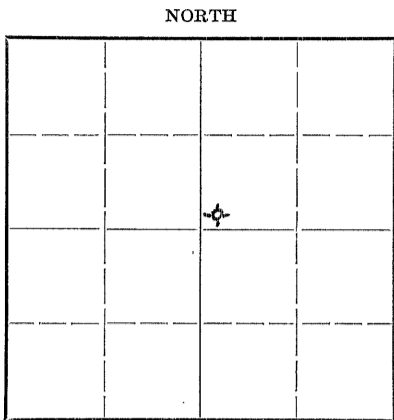

Locate well correctly on above
Section Plat

Name of Conservation Agent who supervised plugging of this well M. A. Rives
Producing formation Depth to top Bottom Total Depth of Well 3818 Feet
Show depth and thickness of all water, oil and gas formations.

OIL, GAS OR WATER RECORDS

CASING RECORD

Formation	Content	From	To	Size	Put In	Pulled Out
				8-5/8"	135'	none
				5 1/2"	3700	1131
					3776 RES CAP	

Describe in detail the manner in which the well was plugged, indicating where the mud fluid was placed and the method or methods used in introducing it into the hold. If cement or other plugs were used, state the character of same and depth placed, from feet to feet for each plug set.

Filled from 3818' to 3515' with crushed rock. Run 5 sax cement at 3515' with dump bailer. Filled with mud to 135'. Set rock bridge at 135'; dumped 15 sax cement. Filled with mud to 25', set rock bridge, dumped 10 sax cement for cap.

8/6/48

(If additional description is necessary, use BACK of this sheet)

Correspondence regarding this well should be addressed to Virginia Drilling Company, Inc.
Address 701 Brown Building, Wichita 2, Kansas

STATE OF Kansas, COUNTY OF Sedgwick, ss.


(employee of owner) or (owner or operator) of the above-described well, being first duly sworn on oath, says: That I have knowledge of the facts, statements, and matters herein contained and the log of the above-described well as filed and that the same are true and correct. So help me God.

(Signature) SA Murphy
701 Brown Building, Wichita 2, Kansas
(Address)

SUBSCRIBED AND SWORN to before me this 5th day of August, 1948

My commission expires 2/5/49

Notary Public.

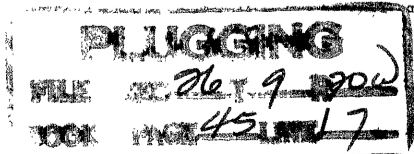

Well: Steeples #1
 Location: SW/cor. NE/4 Sec. 26-9S-20W, Rooks County, Kansas
 Company: Virginia Drilling Company, Inc. and I. O. Miller
 Contractor: Virginia Drilling Company, Inc.
 Commenced: May 6, 1948
 Completed: July 6, 1948
 Total Depth: 3818
 Elevation: 2233

FORMATION	DEPTH	TOPS:	
Gravel	0-10	Topeka	3245
Post Rock	10-20	Dodge	3473
Sand	20-58	Lansing-KC	3492
Shells	58-80	Conlomerate	3741
Shale, shells & sand	80-130	Arbuckle	3779
Shells	130-135		
Shale-shells	135-250		
Shale-blue	260-400		
Sand-shale-shells	400-725	3535	1 hr.
Sand	725-795	3586	1 hr.
Sand-shale-shells	795-1190	3792	2 1/2 hrs.
Sand	1190-1250		
Shale-shells	1250-1691		
Anhydrite	1691-1736	Set 8-5/8" @ 135'	
Shale-shells	1736-2285	3790' 5 1/2" set @ 3779	
Broken lime-shale	2285-2375		
Shale-lime	2375-2425		
Shale-lime-sharp sand	2405-2505		
Lime-shale	2505-2570		
Lime	2570-2600		
Sand-pyrite-lime	2600-2620		
Shale-lime	2720-2970		
Lime	2970-3020		
Lime-shale	3020-2165		
Shale-lime	3165-3250		
Shale-lime	3250-3255		
Lime	3255-3305		
Lime-shale	3305-3370		
Lime	3370-3587		
Lime-some chert	3587-3608		
Lime	3608-3635		
Lime-shale	3635-3675		
Lime	3675-3730		
Lime-shale	3730-3743		
Cherty conglomerate	3743-3797		
<u>CABLE TOOLS</u>			
Arbuckle	3797-3818		

Now comes S. A. Murphy, who states that he is familiar with the drilling of oil and gas wells and knows of his own knowledge that the Steeples #1, located in the SW/corner of the NE/4 of Section 26-9S-20W, Rooks County, Kansas, was drilled to a total depth of 3818 feet. Same was plugged and abandoned.

S. A. Murphy

Subscribed and sworn to before me, a Notary Public, this 30th day of July.

Marlee Hawk

My commission expires February 5, 1949.

