


WELL PLUGGING RECORD

Give All Information Completely
Make Required Affidavit
Mail or Deliver Report to:
Conservation Division
State Corporation Commission
211 No. Broadway
Wichita, Kansas

Rooks County, Sec. 26 Twp. 9 S. Rge. 20 (W)
Location as "NE/CNW/SW" or footage from lines SW NE NW/4
Lease Owner McKnab Production Company, Inc.
Lease Name Zelma Meade, et al Well No. 1
Office Address 1028 Midland Savings Building, Denver, Colorado
Character of Well (completed as Oil, Gas or Dry Hole) Dry Hole
Date well completed May 12, 19 68
Application for plugging filed May 12, 19 68
Application for plugging approved May 12, 19 68
Plugging commenced May 12, 19 68
Plugging completed May 13, 19 68
Reason for abandonment of well or producing formation Dry Hole

NORTH

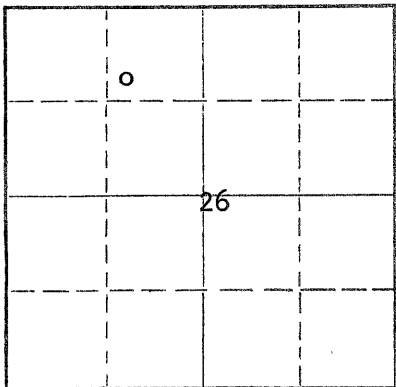

Locate well correctly on above
Section Plat

If a producing well is abandoned, date of last production -- 19
Was permission obtained from the Conservation Division or its agents before plugging was commenced? Yes, by telephone

Name of Conservation Agent who supervised plugging of this well Leo Massey
Producing formation _____ Depth to top _____ Bottom _____ Total Depth of Well 3852 Feet
Show depth and thickness of all water, oil and gas formations.

OIL, GAS OR WATER RECORDS

CASING RECORD

FORMATION	CONTENT	FROM	TO	SIZE	PUT IN	PULLED OUT

Describe in detail the manner in which the well was plugged, indicating where the mud fluid was placed and the method or methods used in introducing it into the hole. If cement or other plugs were used, state the character of same and depth placed, from _____ feet to _____ feet for each plug set.

Set plug at 800' with 70 sacks cement. Mudded up to 240'.

Set plug with 20 sacks cement. Mudded up to 40'.

Set plug with 10 sacks cement and filled hole to surface with cement.

RECEIVED
STATE CORPORATION COMMISSION
MAY 15 1968
CONSERVATION DIVISION
Wichita, Kansas

(If additional description is necessary, use BACK of this sheet)
Name of Plugging Contractor Globe Oilwell Cementing, Inc.
Address Box 628, Great Bend, Kansas

STATE OF Kansas COUNTY OF Sedgwick, ss.
F. S. Woodside, Jr., drilling contractor (employee of owner) or (owner or operator) of the above-described well, being first duly sworn on oath, says: That I have knowledge of the facts, statements, and matters herein contained and the log of the above-described well as filed and that the same are true and correct. So help me God.

(Signature) F. S. Woodside, Jr.
427 Union Center, Wichita, Kansas
(Address)

SUBSCRIBED AND SWORN TO before me this 14th day of May, 19 68.

My commission expires February 28, 1971. Mary L. Lawrence, Notary Public.

ROTARY DRILLING LOG

Operator: McKnab Production Company, Inc. Contractor: Omega Drilling, Inc.
 #1 Meade
 SW NE NW/4 26-9S-20W Commenced: May 5, 1968
 Rooks County, Kansas Completed: May 12, 1968
 Casing: 8 5/8" surface casing
 cemented at 243' with
 170 sacks cement.

FORMATIONS

252'	Surface clay and sand
1180'	Shale, shells and sand
1734'	Shale
1773'	Anhydrite
2145'	Shale
2547'	Shale and lime
2610'	Lime
3360'	Lime and shale
3775'	Lime
3812'	Lime and chert
3830'	Lime
3852'	Lime and chert
3852'	Rotary Total Depth

RECEIVED
 STATE CORPORATION COMMISSION
 MAY 15 1968
 CONSERVATION DIVISION
 Wichita, Kansas

We certify that the above log is true and correct to the best of our knowledge and belief.

OMEGA DRILLING, INC.

By *F. S. Woodside, Jr.*
 F. S. Woodside, Jr.
 President

Subscribed and sworn to before me, a Notary Public, in and for the State of Kansas, County of Sedgwick, this 14th day of May, 1968.

Mary L. Lawrence
 Mary L. Lawrence, Notary Public

My commission expires February 28, 1971.