


STATE OF KANSAS  
STATE CORPORATION COMMISSION

Give All Information Completely  
Make Required Affidavit  
Mail or Deliver Report to  
Conservation Division  
State Corporation Commission  
245 North Water  
Wichita, KS 67202

FORM CP-4

WELL PLUGGING RECORD

Rooks County. Sec. 26 Twp. 9 Rge. 20 (N) (W)  
Location as "NE/CNW/SW" or footage from lines SW SW SW  
Lease Owner Nadel and Gussman  
Lease Name MARCOTTE Well No. 4  
Office Address 3232 First National Tower - Tulsa, Oklahoma 74103  
Character of Well (completed as Oil, Gas or Dry Hole) oil  
Date well completed 4-10 19 53  
Application for plugging filed 4-26 19 77  
Application for plugging approved 4-28 19 77  
Plugging commenced 5-5 19 77  
Plugging completed 5-6 19 77  
Reason for abandonment of well or producing formation Depleted  
If a producing well is abandoned, date of last production -- 19  
Was permission obtained from the Conservation Division or its agents before plugging was commenced? Yes

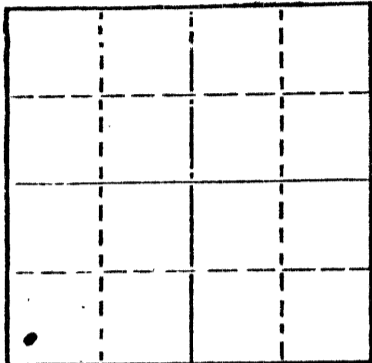

Locate well correctly on above  
Section Plat

Name of Conservation Agent who supervised plugging of this well Leo Massey  
Producing formation Arbuckle Depth to top 3823 Bottom 3829 Total Depth of Well 3829 Feet  
Show depth and thickness of all water, oil and gas formations.

OIL, GAS OR WATER RECORDS

CASING RECORD

FORMATION	CONTENT	FROM	TO	SIZE	PUT IN	PULLED OUT
				5-1/2"	3829	None

Describe in detail the manner in which the well was plugged, indicating where the mud fluid was placed and the method or methods used in introducing it into the hole. If cement or other plugs were used, state the character of same and depth placed, from \_\_\_\_\_ feet to \_\_\_\_\_ feet for each plug set.

Plug back w/sand to 3792' - Squeezed the surface pipe. Pumped 3 sacks of hulls and 163 sacks of cement. 50-50 Poz w/6% Gel.

RECEIVED  
STATE CORPORATION COMMISSION  
MAY 31 1977  
CONSERVATION DIVISION  
Wichita, Kansas

(If additional description is necessary, use BACK of this sheet)  
Name of Plugging Contractor Company plugged and United Cementing  
Address (same as above)

STATE OF OKLAHOMA COUNTY OF TULSA ss.  
Fred C. Rupp, Jr. (employee of owner) or (owner or operator) of the above-described

well, being first duly sworn on oath, says: That I have knowledge of the facts, statements, and matters herein contained and the log of the above-described well as filed and that the same are true and correct. So help me God.

(Signature) Fred C. Rupp, Jr.  
3232 First National Tower - Tulsa, Oklahoma 74103  
(Address)

SUBSCRIBED AND SWORN TO before me this 27th day of May, 19 77

My commission expires May 11, 1979  
Mildred Carter  
Mildred Carter Notary Public.

4-11-53

15-163-01763-00-00

WELL LOG

Nadel and Gusstman

MARCOTTE No. 4

SW SW SW 26-9S-20W  
Rooks County, Kansas

Comm: 3-30-53  
Comp: 4-10-53

Casing: 10-3/4" 124' w/100' sax  
7" 3824' w/100' sax

<u>Formations</u>	<u>Depth</u>	<u>Elev. G- 2262</u> <u>DF 2265</u>	<u>Geological Tops</u>
Surface	124		
Shale, shells and sand	1000		
Shale and sand	1500		
Shale and shells	1736		
Anhydrite	1773	Heepner Shale	3482
Shells and Shale	2010	Toronto Lime	3506
Shale and lime	2350	Lansing-K.C.	3522
Shale and broken lime	2425	Conglomerate	3776
Shale and lime	2689	Simpson	3800
Lime	3720	Arbuckle	3823
Lime and shale	3772		
Lime and Conglomerate	3817		
Shale	3823		
Dolomite	3829		

RECEIVED  
STATE CORPORATION COMMISSION

APR 28 1977

CONSERVATION DIVISION  
Wichita, Kansas

STATE OF KANSAS )  
COUNTY OF SEDGWICK ) SS:

L. C. Hay, of lawful age, deposes and states that the above formations and depths are correct as shown by the daily drilling log of the Marcotte No. 4 in the SW SWSW of 26-9S-20W, Rooks County, Kansas.

L. C. Hay

Subscribed and sworn to before me this 16th day of April, 1953.

W. L. B. B...  
Notary Public

My commission expires Nov. 3, 1956