


15-163-01732-00-00

STATE OF KANSAS
STATE CORPORATION COMMISSION

Give All Information Completely
Make Required Affidavit
Mail or Deliver Report to
Conservation Division
State Corporation Commission
245 North Water
Wichita, KS 67202

FORM CP-4

WELL PLUGGING RECORD

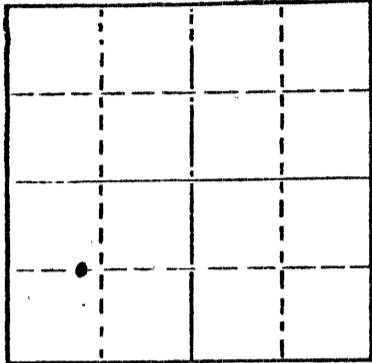

Locate well correctly on above
Section Plot

Rooks County. Sec. 26 Twp. 9 Rge. 20 (W)
Location as "NE/CNW/SW" or footage from lines C E/2 W/2 SW
Lease Owner Nadel and Gussman
Lease Name MARCOTTE Well No. 3
Office Address 3232 First National Tower - Tulsa, Oklahoma 74103
Character of Well (completed as Oil, Gas or Dry Hole) Oil
Date well completed 3-14 1949
Application for plugging filed 4-26 1977
Application for plugging approved 4-28 1977
Plugging commenced 5-4 1977
Plugging completed 5-5 1977
Reason for abandonment of well or producing formation Depleted Zone

If a producing well is abandoned, date of last production -- 19
Was permission obtained from the Conservation Division or its agents before plugging was commenced? Yes

Name of Conservation Agent who supervised plugging of this well Leo Massey
Producing formation Arbuckle Depth to top 3830 Bottom 3884 Total Depth of Well 3884
Show depth and thickness of all water, oil and gas formations.

OIL, GAS OR WATER RECORDS

CASING RECORD

FORMATION	CONTENT	FROM	TO	SIZE	PUT IN	PULLED OUT
				5-1/2	3856	None

Describe in detail the manner in which the well was plugged, indicating where the mud fluid was placed and the method or methods used in introducing it into the hole. If cement or other plugs were used, state the character of same and depth placed, from _____ feet to _____ feet for each plug set.

Plugged back w/sand to 3775' - Pumped 3 sacks of hulls and 163 sacks of cement and squeezed surface casing. (50-50 Poz w/6% Gel)

RECEIVED
STATE CORPORATION COMMISSION
5/31/77
MAY 31 1977
CONSERVATION DIVISION
Wichita, Kansas

(If additional description is necessary, use BACK of this sheet)
Name of Plugging Contractor Company plugged and United cementing.
Address (same as above)

STATE OF OKLAHOMA COUNTY OF TULSA, ss.
Fred C. Rupp, Jr. (employee of owner) or (owner or operator) of the above-described well, being first duly sworn on oath, says: That I have knowledge of the facts, statements, and matters herein contained and the log of the above-described well as filed and that the same are true and correct. So help me God.

(Signature) Fred C. Rupp, Jr.
3232 First National Tower - Tulsa, Oklahoma 74103
(Address)

SUBSCRIBED AND SWORN TO before me this 27th day of May 1977

My commission expires May 11, 1979
Mildred Carter
Mildred Carter Notary Public.

DRILLER'S LOG

Company: Nadel and Gussman

Sec. 26 Twp. 9S Rge. 20W
C E/2 W/2 SW 1/4

Farm: Marcotte Well No. 3

County: Rooks
Kansas

Total Depth: (3884') (Rotary)

Coma.: 3-2-49 Comp.: 3-14-49

Contractor: Glenn Peel Drilling Co., Inc.

Elevation: 2248 ~~DF~~

Casing:

8 5/8" 124' cem.

Production:

5 1/2" 3883' cem.

Figures below indicate bottom of formations

Surface Clay	0 -	30
Sand		75
Shale and Sand		124
Shale and Shells		580
Sand and Shale		675
Shale and Shells		910
Sand and Shale		1090
Shale and Shells		1715
Anhydrite		1750
Red Bed and Shale		1820
Shale and Shells		1880
Shale and Lime Streaks		2028
Shale and Lime		2153
Lime and Shale		2612
Lime		2665
Lime and Shale		2859
Lime		2929
Lime and Shale		2993
Shale and Lime		3120
Lime and Shale		3334
Shale and Lime		3410
Lime and Shale		3475
Lime		3810
Conglomerate		3837
Dolomite		3884
Total Depth		3884

RECEIVED
STATE CORPORATION COMMISSION

APR 28 1977

CONSERVATION DIVISION
Wichita, Kansas

This is to certify that the above information is, to the best of our knowledge, true and correct.

GLENN PEEL DRILLING COMPANY, INC.

BY: Wm Herbert

SUBSCRIBED AND SWORN to before me this 16th day of March, 1949

My commission expires June 4, 1951

Marion M. Herbert
Notary Public