


STATE OF KANSAS
STATE CORPORATION COMMISSION

Give All Information Completely
Make Required Affidavit
Mail or Deliver Report to
Conservation Division
State Corporation Commission
245 North Water
Wichita, KS 67202

FORM CP-4

WELL PLUGGING RECORD

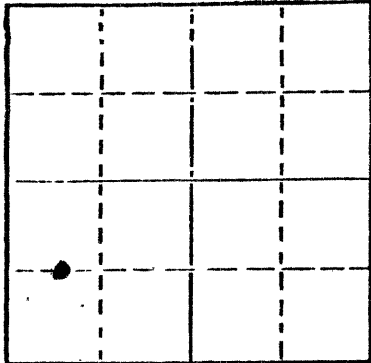

Locate well correctly on above
Section Plat

Rooks _____ County, Sec. 26 Twp. 9 Rge. 20 (N) (W)
Location as "NE/CNW/SW" or footage from lines C W/2 W/2 SW
Lease Owner Nadel and Gussman
Lease Name MARCOTTE Well No. 2
Office Address 3232 First National Tower - Tulsa, Oklahoma 74103
Character of Well (completed as Oil, Gas or Dry Hole) Oil
Date well completed 5-26 19 48
Application for plugging filed 6-9 19 77
Application for plugging approved 6-10 19 77
Plugging commenced 6-15 19 77
Plugging completed 6-16 19 77
Reason for abandonment of well or producing formation Uneconomical to continue operation.
If a producing well is abandoned, date of last production _____ 19 ____
Was permission obtained from the Conservation Division or its agents before plugging was commenced? Yes

Name of Conservation Agent who supervised plugging of this well Leo Massey
Producing formation Arbuckle Depth to top 3804' Bottom 3812' Total Depth of Well 3812' Feet
Show depth and thickness of all water, oil and gas formations.

OIL, GAS OR WATER RECORDS

CASING RECORD

FORMATION	CONTENT	FROM	TO	SIZE	PUT IN	PULLED OUT
				5 1/2"	3809' <u>W/2 SW</u>	None
					3812'	

Describe in detail the manner in which the well was plugged, indicating where the mud fluid was placed and the method or methods used in introducing it into the hole. If cement or other plugs were used, state the character of same and depth placed, from _____ feet to _____ feet for each plug set.

Plug back T.D. with cement 3025' - Pumped 3 sacks of hulls 20 sacks of gel and 150 sacks of 50-50 poz w/6% gel down surface casing.

(If additional description is necessary, use BACK of this sheet)
Name of Plugging Contractor Company plugged and Allied Cementing
Address _____

STATE OF OKLAHOMA COUNTY OF TULSA, ss.
Fred C. Rupp, Jr. (employee of owner) or (owner or operator) of the above-described well, being first duly sworn on oath, says: That I have knowledge of the facts, statements, and matters herein contained and the log of the above-described well as filed and that the same are true and correct. So help me God.

(Signature) Fred C. Rupp, Jr.
3232 First National Tower - Tulsa, Okla. 74103
(Address)

SUBSCRIBED AND SWORN TO before me this 29th day of June, 19 77

My commission expires May 11, 1979
Mildred Carter
Mildred Carter Notary Public.

15-163-01731-00-00

WELL LOG

MARCOTTE No. 2

NADEL AND GUSSMAN

CW/2 W/2 SW 26-9-20W
Rooks County, Kansas

Comm. 5-11-48
Comp. 5-26-48

Casing Record:

8-5/8" 171'
100 sax cement
5-1/2" 3809'
100 sax cement

<u>Formation</u>	<u>Depth</u>
Shale	30
Sane	100
Shale and sand	171
Shale and shells	850
Shale and sand	1180
Shale and shells	1720
Lime and Anhydrite	1750
Shale and Anhydrite	1800
Shale, shells & red bed	1920
Lime and shale	2305
Lime	2620
Shale and red bed	2665
Shale and shells with lime streaks	2853
Shale and shells	3035
Shale and lime	3395
Lime	3470
Broken Lime	3490
Lime	3760
Chert	3778
Shale and lime breaks	3800
Conglomerate	3809
Artuckle	3812 T.D.

Elevation 2259 DF

RECORDED
MINERAL COMMISSION

JUN 10 1977

NOTARY PUBLIC
MOORE, KANSAS



I hereby certify that the above formations and depths are true and correct as taken from the daily drilling reports of the Marcotte No. 2 Well.

L. C. Hay
President - Reserve Drilling
Company, Inc.

Subscribed and sworn to before me this 29th day of May, 1948.

Notary Public in and
for Sedgwick County, Kansas

My commission expires Nov. 3, 1948