

CARD MUST BE TYPED

State of Kansas
NOTICE OF INTENTION TO DRILL
(see rules on reverse side)

CARD MUST BE SIGNED

Starting Date: 6/14/85
month day year 3:50

API Number 15- 107-22622-00-00

OPERATOR: License # 6004
Name Caldwell Enterprises
Address P.O. Box 42
City/State/Zip Garnett, KS 66032
Contact Person Glen Caldwell
Phone 913-448-3578

NW SE NE 21 20 22 East
Sec Twp S, Rge West
(location)

CONTRACTOR: License # 5820
Name Milton J. Kent
City/State Garnett, KS 66032

3740 Ft North from Southeast Corner of Section
2000 Ft West from Southeast Corner of Section
(Note: Locate well on Section Plat on reverse side)

Nearest lease or unit boundary line 680 feet.
County Linn
Lease Name Nickell Well# 21

Well Drilled For: Well Class: Type Equipment:
 Oil Swd Infield Mud Rotary
 Gas Inj Pool Ext. Air Rotary
 OWWO Expl Wildcat Cable

Domestic well within 330 feet: yes no
Municipal well within one mile: yes no

If OWWO: old well info as follows:
Operator
Well Name
Comp Date Old Total Depth
Projected Total Depth 650 feet
Projected Formation at TD Squirrel
Expected Producing Formations

Depth to Bottom of fresh water 30 feet
Lowest usable water formation
Depth to Bottom of usable water 150 feet
Surface pipe by Alternate: 1 2
Surface pipe to be set 20 feet
Conductor pipe if any required feet
Ground surface elevation feet MSL

This Authorization Expires
Approved By 6-13-85 [Signature]

I certify that we will comply with K.S.A. 55-101, et seq., plus eventually plugging hole to K.C.C. specifications.

Date 6/13/85 Signature of Operator or Agent [Signature]

Title [Signature]

WMC/UDHE 6-13-85
As Agent

RECEIVED
 This card void if drilling not started within six (6) months of date received by K.C.C.
 STATE CORPORATION COMMISSION


JUN 13 1985

6-13-85

Important procedures to follow :

CONSERVATION DIVISION
A Regular Section of Land, Kansas
 1 Mile = 5,280 Ft.

1. Notify District office before setting surface casing.
2. Set surface casing by circulating cement to the top.
3. File completion forms ACO-1 with K.C.C. within 90 days of well completion, following instructions on ACO-1, side 1, and including copies of wireline logs.
4. Notify District office 48 hours prior to old well workover or re-entry.
5. Prior to plugging, prepare a plugging plan, then obtain agreement from the appropriate district office for an approved plugging plan.
6. Submit plugging report (CP-4) to K.C.C. after plugging is completed.
7. Obtain an approved injection docket number before disposing of salt water.
8. Notify K.C.C. within 10 days when injection commences or terminates.
9. If an alternate 2 completion, cement in the production pipe from below any usable water to surface within 120 days of spud date.

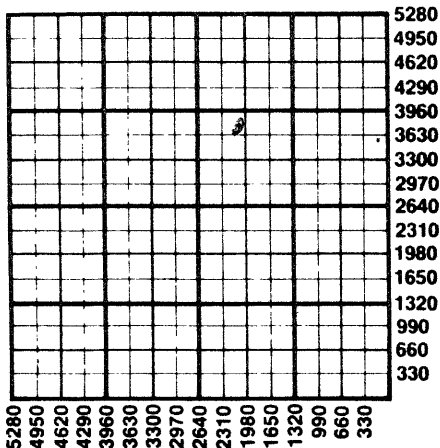

State Corporation Commission of Kansas
Conservation Division
200 Colorado Derby Building
Wichita, Kansas 67202
(316) 263-3238