

CARD MUST BE TYPED

State of Kansas  
NOTICE OF INTENTION TO DRILL

(see rules on reverse side)

CARD MUST BE SIGNED

Starting Date: 6 18 85  
month day year *ZAS*

API Number 15- *107-22,624-00-00*  
XX

OPERATOR: License # 6004  
Name Caldwell Enterprises  
Address Box 42  
City/State/Zip Garnett, KS 66032  
Contact Person Glen Caldwell  
Phone (913) 448-3578

NE SW NE 21 20 22  East  
(location) Sec Twp S, Rge  West  
3340  
1800 Ft North from Southeast Corner of Section  
Ft West from Southeast Corner of Section  
(Note: Locate well on Section Plat on reverse side)  
440

CONTRACTOR: License # 5820  
Name Milton J. Kent  
City/State Garnett, KS 66032

Nearest lease or unit boundary line *Linn* feet.  
County *Nickell* 23  
Lease Name Well#

Well Drilled For: Well Class: Type Equipment:  
 Oil  Swd  Infield  Mud Rotary  
 Gas  Inj  Pool Ext.  Air Rotary  
 OWWO  Expl  Wildcat  Cable

Domestic well within 330 feet:  yes  no  
Municipal well within one mile:  yes  no

If OWWO: old well info as follows:  
Operator  
Well Name  
Comp Date Old Total Depth  
Projected Total Depth 650 feet  
Projected Formation at TD Squirrel  
Expected Producing Formations

Depth to Bottom of fresh water 20 feet  
Lowest usable water formation  
Depth to Bottom of usable water 150 feet  
Surface pipe by Alternate: 1  2   
Surface pipe to be set feet  
Conductor pipe if any required feet  
Ground surface elevation feet MSL  
This Authorization Expires *12-18-85*  
Approved By *6-18-85*

I certify that we will comply with K.S.A. 55-101, et seq., plus eventually plugging hole to K.C.C. specifications.

Date *6/18/85* Signature of Operator or Agent

*Luanne Corliss* Title

*MHC/40HE 6-18-85*  
As Agent

RECEIVED  
STATE CORPORATION COMMISSION

Must be filed with the K.C.C. five (5) days prior to commencing well  
drilling not started within six (6) months of date received by K.C.C.


JUN 18 1985

6-18-85

CONSERVATION DIVISION  
Wichita, Kansas  
**A Regular Section of Land**  
**1 Mile = 5,280 Ft.**

**Important procedures to follow :**

1. Notify District office before setting surface casing.
2. Set surface casing by circulating cement to the top.
3. File completion forms ACO-1 with K.C.C. within 90 days of well completion, following instructions on ACO-1, side 1, and including copies of wireline logs.
4. Notify District office 48 hours prior to old well workover or re-entry.
5. Prior to plugging, prepare a plugging plan, then obtain agreement from the appropriate district office for an approved plugging plan.
6. Submit plugging report (CP-4) to K.C.C. after plugging is completed.
7. Obtain an approved injection docket number before disposing of salt water.
8. Notify K.C.C. within 10 days when injection commences or terminates.
9. If an alternate 2 completion, cement in the production pipe from below any usable water to surface within 120 days of spud date.

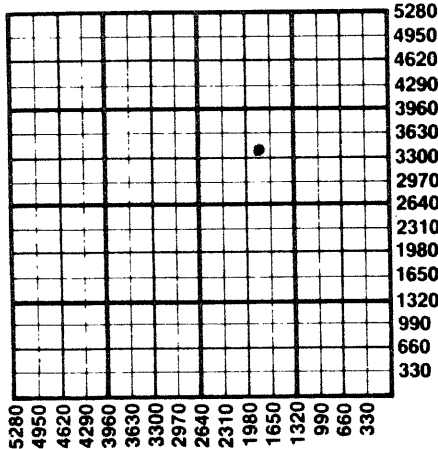

State Corporation Commission of Kansas  
Conservation Division  
200 Colorado Derby Building  
Wichita, Kansas 67202  
(316) 263-3238