

CARD MUST BE TYPED

State of Kansas
NOTICE OF INTENTION TO DRILL
(see rules on reverse side)

CARD MUST BE SIGNED

Starting Date:6.....19.....84.....
month day year 3:50

API Number 15- 107-22,311-00-00

OPERATOR: License #6004.....

.....SW Sec .21. Twp 20.. S, Rge 22... East
(location) West

NameCaldwell Enterprises.....

AddressBox 42.....

City/State/ZipGarnett, KS... 66032.....

Contact PersonGlen Caldwell.....

Phone913.448-3578.....

.....1540..... Ft North from Southeast Corner of Section
.....3740..... Ft West from Southeast Corner of Section
(Note: Locate well on Section Plat on reverse side)

CONTRACTOR: License #5820.....

Nearest lease or unit boundary line ... 1540..... feet.

NameMilton J. Kent.....

CountyLinn.....

City/StateGarnett, KS... 66032.....

Lease NameCox..... Well# 5.....

Well Drilled For: Well Class: Type Equipment:

- | | | | |
|---|-------------------------------|---|--|
| <input checked="" type="checkbox"/> Oil | <input type="checkbox"/> Swd | <input checked="" type="checkbox"/> Infield | <input checked="" type="checkbox"/> Mud Rotary |
| <input type="checkbox"/> Gas | <input type="checkbox"/> Inj | <input type="checkbox"/> Pool Ext. | <input type="checkbox"/> Air Rotary |
| <input type="checkbox"/> OWWO | <input type="checkbox"/> Expl | <input type="checkbox"/> Wildcat | <input type="checkbox"/> Cable |

Domestic well within 330 feet : yes no

Municipal well within one mile : yes no

If OWWO: old well info as follows:

Depth to Bottom of fresh water 1540..... feet

Lowest usable water formationIola Limestone.....

Depth to Bottom of usable water 150..... feet

Surface pipe by Alternate : 1 2

Surface pipe to be set 20..... feet

Conductor pipe if any required feet

Ground surface elevation feet MSL

This Authorization Expires 12-18-84.....

Approved By 6-18-84.....

I certify that we will comply with K.S.A. 55-101, et seq., plus eventually plugging hole to K.C.C. specifications.

Date 6/18/84..... Signature of Operator or Agent

Wianne Corliss Title *As Agent*

MHC/KOHE 6-18-84 Form C-1 4/84


RECEIVED
STATE CORPORATION COMMISSION

Must be filed with the K.C.C. five (5) days prior to commencing well
This card void if drilling not started within six (6) months of date received by K.C.C.

JUN 18 1984

6-18-84

CONSERVATION DIVISION
A Regular Section of Land
1 Mile = 5,280 Ft.

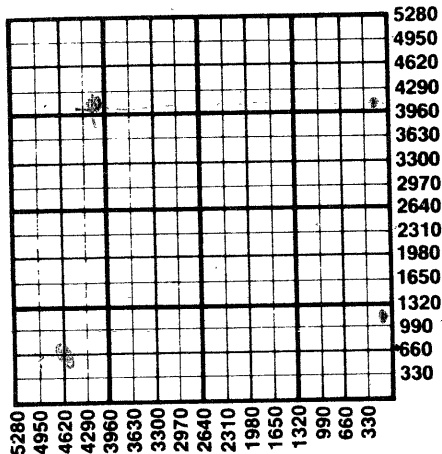

Important procedures to follow :

1. Notify District office before setting surface casing.
2. Set surface casing by circulating cement to the top.
3. File completion forms ACO-1 with K.C.C. within 90 days of well completion, following instructions on ACO-1, side 1, and including copies of wireline logs.
4. Notify District office 48 hours prior to old well workover or re-entry.
5. Prior to plugging, prepare a plugging plan, then obtain agreement from the appropriate district office for an approved plugging plan.
6. Submit plugging report (CP-4) to K.C.C. after plugging is completed.
7. Obtain an approved injection docket number before disposing of salt water.
8. Notify K.C.C. within 10 days when injection commences or terminates.
9. If an alternate 2 completion, cement in the production pipe from below any usable water to surface within 120 days of spud date.

State Corporation Commission of Kansas
Conservation Division
200 Colorado Derby Building
Wichita, Kansas 67202
(316) 263-3238