

CARD MUST BE TYPED

State of Kansas

CARD MUST BE SIGNED

NOTICE OF INTENTION TO DRILL

(see rules on reverse side)

Starting Date 3 14 86
month day year

API Number 15— 163-22878-00-00

OPERATOR: License # 5140
Name Frontier Oil Company
Address 1720 Kansas State Bk Bldg.
City/State/Zip Wichita, Kansas 67202
Contact Person George A. Angle
Phone 316-263-1201

NE NW SW NE Sec. 7 Twp. 9S S, Rg. 20W East
3795 Ft. from South Line of Section
2145 Ft. from East Line of Section

(Note: Locate well on Section Plat on reverse side)

CONTRACTOR: License # 5302
Name Red Tiger Drilling Co.
City/State Wichita, Kansas 67202

Nearest lease or unit boundary line 565 feet
County Rooks
Lease Name Desmarteau Well # 3

Well Drilled For: Well Class: Type Equipment:
 Oil SWD Infield Mud Rotary
 Gas Inj Pool Ext. Air Rotary
 OWWO Expl Wildcat Cable

Ground surface elevation feet MSL
Domestic well within 330 feet: yes no
Municipal well within one mile: yes no
Depth to bottom of fresh water 100
Depth to bottom of usable water Dakota 700

If OWWO: old well info as follows:
Operator
Well Name
Comp Date Old Total Depth

Surface pipe by Alternate: 1 2
Surface pipe planned to be set 215
Conductor pipe required N/A
Projected Total Depth 3800 feet
Formation AFB

I certify that well will comply with K.S.A. 55-101, et seq., plus specifications.
Date 3/11/86 Signature of Operator or Agent Title OWNER

George A. Angle

For KCC Use:
Conductor Pipe Required feet: Minimum Surface Pipe Required 200 feet per A1042
This Authorization Expires 3-11-86 Approved By 3-11-86


POA/KOH

Must be filed with the K.C.C. five (5) days prior to commencing well
This card void if drilling not started within six (6) months of date received by K.C.C.

Important procedures to follow:

1. Notify District office before setting surface casing.
2. Set surface casing by circulating cement to the top.
3. File completion forms ACO-1 with K.C.C. within 90 days of well completion, following instructions on ACO-1, side 1, and including copies of wireline logs.
4. Notify District office 48 hours prior to old well workover or re-entry.
5. Prior to filing Intent, prepare a proposed plugging plan in case well is D & A, then obtain approval of plan when calling district office prior to setting surface pipe.
6. Submit plugging report (CP-4) to K.C.C. after plugging is completed.
7. Obtain an approved injection docket number before disposing of salt water.
8. Notify K.C.C. within 10 days when injection commences or terminates.
9. If an alternate 2 completion, cement in the production pipe from below any usable water to surface within 120 days of spud date.

A Regular Section of Land 1 Mile = 5,280 Ft.

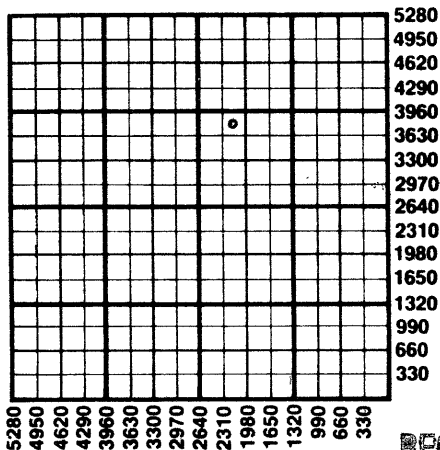

RECEIVED
STATE CORPORATION COMMISSION

3/11/86
MAR 11 1986

CONSERVATION DIVISION
Wichita, Kansas

State Corporation Commission of Kansas
Conservation Division
200 Colorado Derby Building
Wichita, Kansas 67202
(316) 263-3238