

CARD MUST BE TYPED

State of Kansas NOTICE OF INTENTION TO DRILL

CARD MUST BE SIGNED

Starting Date: 5 16 85

month day year
5140

API Number 15-

163-22, 687-00-00

OPERATOR: License #

N/2. N/2. S/2 Sec 7. Twp 9S. S. Rge 20W.

☐ East☒ West

(location)

2310. Ft North from Southeast Corner of Section

2640. Ft West from Southeast Corner of Section

(Note: Locate well on Section Plat on reverse side)

Nearest lease or unit boundary line 330 feet.

County Rooks

Lease Name Desmarteau Well# 2

Domestic well within 330 feet: ☐ yes ☒ no

Municipal well within one mile: ☐ yes ☒ no

Depth to Bottom of fresh water 100 feet

Lowest usable water formation Dakota

Depth to Bottom of usable water 900 feet

Surface pipe by Alternate: 1 ☐ 2 ☒

Surface pipe to be set 175 200 feet

Conductor pipe if any required N/A feet

Ground surface elevation feet MSL

This Authorization Expires 11-13-85

Approved By 5-13-85

PRODUCTION STRING
WILL BE CEMENTED
IMMEDIATELY

Owner

Form C-1 4/84

MHC/LOHE 5-13-85

Well Drilled For:

Well Class:

Type Equipment:

☒ Oil☐ Swd☐ Infield☒ Mud Rotary☐ Gas☐ Inj☒ Pool Ext.☐ Air Rotary☐ OWWO☐ Expl☐ Wildcat☐ Cable

If OWWO: old well info as follows:

Operator

Well Name

Comp Date

Old Total Depth

Projected Total Depth 3700 feet

Projected Formation at TD Arbuckle

Expected Producing Formations Arbuckle

I certify that we will comply with K.S.A. 55-101, et seq., plus eventually plugging hole to K.C.C. specification

Date 5/13/85 Signature of Operator or Agent

Title


George A. Angle

RECEIVED
STATE CORPORATION COMMISSION

5/13/85
MAY 13 1985

CONSERVATION DIVISION
Wichita, Kansas

A Regular Section of Land
1 Mile = 5,280 Ft.

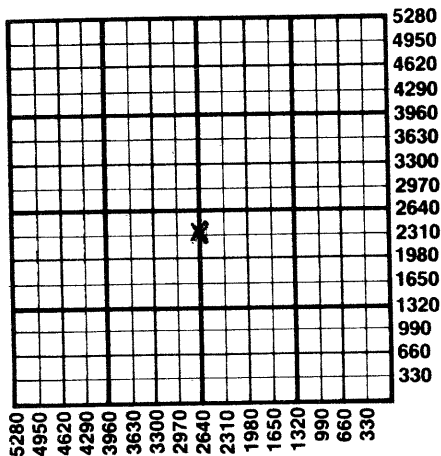

Must be filed with the K.C.C. five (5) days prior to commencing well
completion if drilling not started within six (6) months of date received by K.C.C.

Important procedures to follow:

1. Notify District office before setting surface casing.
2. Set surface casing by circulating cement to the top.
3. File completion forms ACO-1 with K.C.C. within 90 days of well completion, following instructions on ACO-1, side 1, and including copies of wireline logs.
4. Notify District office 48 hours prior to old well workover or re-entry.
5. Prior to plugging, prepare a plugging plan, then obtain agreement from the appropriate district office for an approved plugging plan.
6. Submit plugging report (CP-4) to K.C.C. after plugging is completed.
7. Obtain an approved injection docket number before disposing of salt water.
8. Notify K.C.C. within 10 days when injection commences or terminates.
9. If an alternate 2 completion, cement in the production pipe from below any usable water to surface within 120 days of spud date.

State Corporation Commission of Kansas
Conservation Division
200 Colorado Derby Building
Wichita, Kansas 67202
(316) 263-3238