


STATE OF KANSAS
STATE CORPORATION COMMISSION

Give All Information Completely
Make Required Affidavit
Mail or Deliver Report to:
Conservation Division
State Corporation Commission
212 No. Market
Wichita, Kansas

WELL PLUGGING RECORD

NORTH

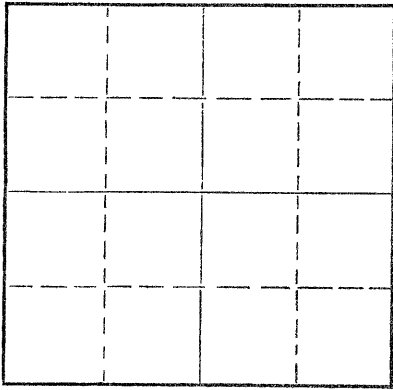

Locate well correctly on above
Section Plat

Rooks County. Sec. 25 Twp. 9 Rge. 18 (E) W (W)
Location as "NE/CNW/SW" or footage from lines. NE NE SW
Lease Owner Black Petroleum, Inc.
Lease Name Moon Well No. 1
Office Address Suite 445, Garvey Bldg. Wichita, Kansas 67202
Character of Well (completed as Oil, Gas or Dry Hole) Dry Hole
Date well completed 10-28 19 70
Application for plugging filed 10-28 19 70
Application for plugging approved 10-28 19 70
Plugging commenced 10-28 19 70
Plugging completed 10-28 19 70
Reason for abandonment of well or producing formation dry hole

If a producing well is abandoned, date of last production 19
Was permission obtained from the Conservation Division or its agents before plugging was commenced? yes

Name of Conservation Agent who supervised plugging of this well Leo Massey
Producing formation _____ Depth to top _____ Bottom _____ Total Depth of Well 3,650 Feet
Show depth and thickness of all water, oil and gas formations.

OIL, GAS OR WATER RECORDS

CASING RECORD

FORMATION	CONTENT	FROM	TO	SIZE	PUT IN	PULLED OUT
				8 5/8"	232'	Cmtd. w/ 150 sa

Describe in detail the manner in which the well was plugged, indicating where the mud fluid was placed and the method or methods used in introducing it into the hole. If cement or other plugs were used, state the character of same and depth placed, from _____ feet to _____ feet for each plug set.

Fill hole w/ heavy mud
Push bridge plug to 720'
Spot 70 sax cement on plug thru 4 1/2" drill pipe
Fill hole w/ heavy mud
Push bridge plug to 210'
Spot 20 sax cement on plug thru 4 1/2" drill pipe
Push bridge plug to 40'
Dump 10 sax cement on plug to cellar

RECEIVED
STATE CORPORATION COMMISSION
NOV 13 1970
CONSERVATION DIVISION
Wichita, Kansas

(If additional description is necessary, use BACK of this sheet)

Name of Plugging Contractor Shields Drilling Co., Inc.
Address Shields Building, Russell, Kansas 67665

STATE OF Kansas, COUNTY OF Russell, ss. Robert J. Shields contractor
well, being first duly sworn on oath, says: That I have knowledge of the facts, statements, and matters herein contained and the log of the above-described well as filed and that the same are true and correct. So help me God.

(Signature) Robert J. Shields
Shields Bldg. Russell, Kansas
(Address)

SUBSCRIBED AND SWORN TO before me this 10th day of November, 19 70

My commission expires May 26, 1971 Leah Phillips Notary Public.



Shields


15-163-20327-00-00

Russell, Kansas

WELL LOG

Operator: Black Petroleum, Inc.
 Well: Moon # 1
 Commenced: October 20, 1970
 Completed: October 28, 1970
 Contractor: Shields Drilling Co., Inc.

Well Description: NE NE SW
 Sec. 25-9s-18w
 Rooks County, Kansas

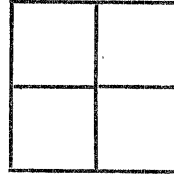

CASING RECORD		
Size	Run	Pulled
8 5/8"	232'	Cmtd w/ 150 sax

Elevation:
 Treatment:
 Production: D & A
 Tops:

..... Figures Indicate Bottom of Formations

Surface soil, clay & shale	238'	
Shale	995'	
Sand	1,105'	
Shale & shells	1,205'	
Shale, shells & redbed	1,458'	
Anhydrite	1,494'	
Shale	1,900'	
Shale & shells	2,275'	
Shale & lime	3,190'	
Lime	3,650'	R T D

RECEIVED
 STATE CORPORATION COMMISSION
 NOV 13 1970
 CONSERVATION DIVISION
 Wichita, Kansas

Notes