

Give All Information Completely
Make Required Affidavit
Mail or Deliver Report to:
Conservation Division
State Corporation Commission
212 No. Market
Wichita, Kansas

WELL PLUGGING RECORD

Rooks County. Sec. 25 Twp. 9 Rge. 18 (E) W (W)

Location as "NE/CNW%SW%" or footage from lines NW SE SW

Lease Owner Landes Exploration Co.

Lease Name Moon Well No. 1

Office Address P. O. Box 867, Magnolia, Arkansas 71753

Character of Well (completed as Oil, Gas or Dry Hole) Dry Hole

Date well completed 4-30 19 70

Application for plugging filed 4-30 19 70

Application for plugging approved 4-30 19 70


Plugging commenced 4-30 19 70

Plugging completed 4-30 19 70

Reason for abandonment of well or producing formation Dry Hole

If a producing well is abandoned, date of last production 19

Was permission obtained from the Conservation Division or its agents before plugging was commenced? Yes

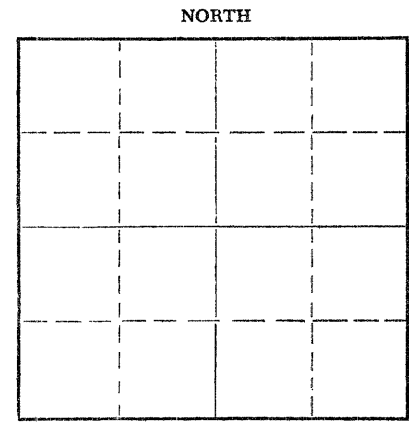

Locate well correctly on above Section Plat

Name of Conservation Agent who supervised plugging of this well Leo Massey

Producing formation _____ Depth to top _____ Bottom _____ Total Depth of Well _____ Feet

Show depth and thickness of all water, oil and gas formations.

OIL, GAS OR WATER RECORDS

CASING RECORD

FORMATION	CONTENT	FROM	TO	SIZE	PUT IN	PULLED OUT
Surface Pipe				8 5/8"	209	

Describe in detail the manner in which the well was plugged, indicating where the mud fluid was placed and the method or methods used in introducing it into the hole. If cement or other plugs were used, state the character of same and depth placed, from _____ feet to _____ feet for each plug set.

- 1st plug was set @ 660' with 70 sacks cement
- 2nd plug was set @ 210' with 20 sacks cement
- 3rd plug was set @ 40' with 10 sacks cement

RECEIVED
STATE CORPORATION COMMISSION
MAY 4 1970
CONSERVATION DIVISION
Wichita, Kansas

(If additional description is necessary, use BACK of this sheet)

Name of Plugging Contractor L. J. Dreiling & Sons, Inc.

Address Route #2, Victoria, Kansas 67671

STATE OF KANSAS, COUNTY OF ELLIS, ss.


I, Leo F. Dreiling (employee of owner) or ~~(owner or operator)~~ of the above-described well, being first duly sworn on oath, says: That I have knowledge of the facts, statements, and matters herein contained and the log of the above-described well as filed and that the same are true and correct. So help me God.

(Signature) Leo F. Dreiling
LEO F. DREILING, ROUTE 2, VICTORIA, KANSAS 67671
(Address)

Subscribed and Sworn to before me this 2nd day of May, 1970

My commission expires September 19, 1970

Joseph A. Hess
Joseph A. Hess Notary Public.

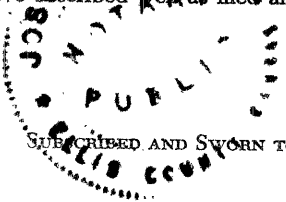

15-163-20307-00-00

L. J. DREILING AND SONS, INC.

Victoria, Kansas 67671

WELL LOG

Company	Landes Exploration Co. P. O. Box 867 Magnolia, Arkansas	Sec. 25	Twp. 9	Rng. 18
Farm	Moon No. 1	Location	NW SE Sw	
Total Depth	3660'	County	Rooks	
Comm.	4-23-70	Comp.	4-30-70	Elevation: 2148' K. B.
Contractor	L. J. Dreiling & Sons, Inc. Victoria, Kansas 67671			2145' D. F.
	Casing Record	Cement Record		2143' G. R.
	209' - 8 5/8"	150 sacks cement	Production:	D & A

Figures Indicate Bottom of Formations

0'	75'	Top Soil - Sand & Clay
75'	116'	Shale
116'	216'	Shale
216'	295'	Shale
295'	1005'	Shale
1005'	1192'	Sand
1192'	1465'	Shale & Red Bed
1465'	1476'	Red Bed & Shale
1476'	1512'	Anhy.
1512'	2080'	Shale
2080'	2380'	Shale
2380'	2580'	Shale & Lime
2580'	2790'	Shale & Lime
2790'	2990'	Shale & Lime
2990'	3180'	Shale & Lime
3180'	3277'	Shale & Lime
3277'	3323'	Shale & Lime
3323'	3360'	Lime
3360'	3426'	Lime
3426'	3440'	Lime
3440'	3497'	Lime
3497'	3555'	Lime
3555'	3572'	Lime
3572'	3660'	Lime
3660'	T.D.	

RECEIVED
STATE CORPORATION COMMISSION
MAY 4 1970
CONSERVATION DIVISION
Wichita, Kansas

STATE OF KANSAS)
)ss
COUNTY OF ELLIS)

I, Leo F. Dreiling, of the L. J. Dreiling & Sons, Inc. upon oath states that the above and foregoing is a true and correct copy from the Daily Drilling Report from your Moon #1.

Leo F. Dreiling

LEO F. DREILING

Subscribed and sworn to before me this 2nd day of May, 1970.

JOSEPH A. HESS
NOTARY PUBLIC
COUNTY OF ELLIS, KANSAS

Joseph A. Hess

JOSEPH A. HESS NOTARY PUBLIC

My Commission Expires: September 19, 1970