

STATE OF KANSAS
STATE CORPORATION COMMISSION
200 Colorado Derby Bldg.
Wichita, Kansas 67202

WELL PLUGGING RECORD

Give All Information Completely
Make Required AffidavitCOUNTY Rooks SEC. 18 TWP. 9 RGE. 20 E/W
Location as in quarters or footage from lines:

SE SW SW

Lease Owner American Petrofina Co. of Texas
 Lease Name Miller #1 Well No. _____
 Office Address Box 209 Russell, Kansas 67665
 Character of Well (Completed as Oil, Gas or Dry Hole): _____
 Date Well Completed April '51
 Application for plugging filed Sept. 28, 1981 - Renewed Feb. 16, 1982
 Plugging commenced 2-16-82
 Plugging completed 2-26-82

Reason for abandonment of well or producing formation _____
 Depleted

Locate Well
correctly on above
Section Plat.

Was permission obtained from the Conservation Division or it's
Agent's before plugging was commenced? Yes

Name of Conservation Agent who supervised plugging of this well Dennis HamelProducing formation Arbuckle Depth to top 3778 1/2 bottom unknown T.D. 3791

Show depth and thickness of all water, oil and gas formations.

OIL, GAS OR WATER RECORDS							Casing Record
Formation	Content	From	To	Size	Put in	Pulled Out	
Arbuckle Dolomite	Oil	3778 1/2	3791	8-5/8"	153'	none	
				(TD) 5-1/2"	3778 1/2	426'	

Describe in detail the manner in which the well was plugged, indicating where the mud fluid was placed and the method or methods used in introducing it into the hole. If cement or other plugs were used, state the character of same and depth placed, from _____ feet to _____ feet for each plug set.

Plugged off bottom with sand to 3700' and ran 5 sacks cement. Shot casing @ 1237', 1000', 672' and 419'. Pulled a total of 14 joints of pipe. Plugged well with 4 sacks hulls, 12 sacks gel, 70 sacks cement, 1 sack hulls, 8 sacks gel, 8-5/8" plug, 70 sacks cement. 50/50 pos, 4% gel. 3% cc. Plugging Complete


(If additional description is necessary, use BACK of this sheet)
 Name of Plugging Contractor Kelso Casing Pulling

STATE OF Kansas COUNTY OF Rice, ss.
 R. Darrell Kelso (employee of owner) or (owner or operator) of the
 above-described well, being first duly sworn on oath, says: That I have knowledge of the
 facts, statements, and matters herein contained and the log of the above-described well as
 filed and that the same are true and correct. So help me God.

MAR 4 1982
3-4-82
RECEIVED
CONSERVATION DIVISION
Wichita, Kansas

(Signature) R. Darrell Kelso
Box 176 Chase, Kansas 67524
(Address)

SUBSCRIBED AND SWORN TO before me this 3rd. day of March, 1982

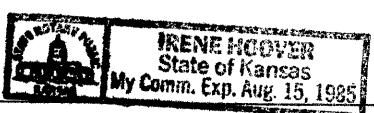

My Commission expires:

Irene Hoover Notary Public.

15-163-19341-00-00
WELL LOG BUREAU - KANSAS GEOLOGICAL SOCIETY
508 E. Hurlock,

Wichita, Kansas

COPY
of Original

Company - PALMER OIL CORP. ET AL
Farm - Miller No. 1

SEC. 18 T. 9 R. 20W
SE SW SW.

Total Depth. 3791

Comm. 3-31-51

Comp. 4-25-51


Shot or Treated.

Contractor. Musgrove Petro. Corp.

Issued. 7-7-51

County. Rocke

KANSAS

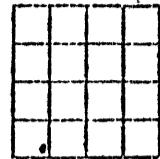

CASING:

8 5/8" 153' cem. w/110 sx.
5 1/2" 3778 1/2 cem. w/75 sx.

Elevation. 2239 R.B.

Production. 116 bbls. Phys.

Figures Indicate Bottom of Formations.

shale & shells	153
shale	1075
shale & sand	1500
shale, shells & red bed	1730
shale	1751
anhyd.	1781
shale & shells	2245
shale & lime	2345
lime brkn	2410
shale & lime	2600
lime brkn	2630
shale & lime	3030
lime brkn	3130
lime & shale	3265
lime	3778
Arb. lime	3780 RTD
Arb. lime	3791
Total Depth	

Tops: R.B.

Heebner	3459
Toronto	3484
Lansing	3498
Base K.C.	3712
Congl.	3756
Simpson	3763
Arb.	3778

Acidized w/1000 gals. on 4-20-51

STATE ~~REGULATED~~
COMMISSION
MAP 10 1022
CONSERVATION DIVISION
Wichita, Kansas