


STATE OF KANSAS
STATE CORPORATION COMMISSION

Give All Information Completely
Make Required Affidavit
Mail or Deliver Report to:
Conservation Division
State Corporation Commission
800 Biting Building
Wichita, Kansas

WELL PLUGGING RECORD

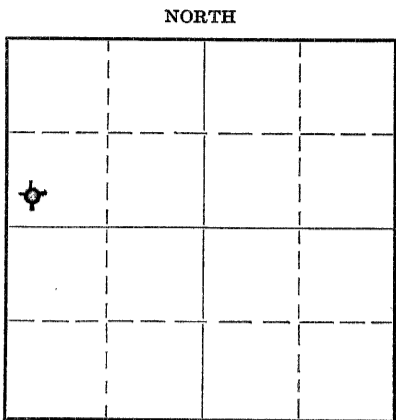

Locate well correctly on above
Section Plat

Rooks County. Sec. 18 Twp. 9 Rge. 20 (X) (W)
Location as "NE/CNW $\frac{1}{4}$ SW $\frac{1}{4}$ " or footage from lines SW SW NW
Lease Owner D. G. Hansen
Lease Name Miller Well No. 1
Office Address Logan, Kansas
Character of Well (completed as Oil, Gas or Dry Hole) Dry Hole
Date well completed August 14 19 51
Application for plugging filed August 14 19 51
Application for plugging approved August 14 19 51
Plugging commenced August 14 19 51
Plugging completed August 14 19 51
Reason for abandonment of well or producing formation too low structurally

If a producing well is abandoned, date of last production 19_____
Was permission obtained from the Conservation Division or its agents before plugging was commenced? Yes

Name of Conservation Agent who supervised plugging of this well Eldon Petty, Hays, Kansas
Producing formation _____ Depth to top _____ Bottom _____ Total Depth of Well _____ Feet
Show depth and thickness of all water, oil and gas formations.

OIL, GAS OR WATER RECORDS

CASING RECORD

Formation	Content	From	To	Size	Put In	Pulled Out
				8-5/8" (25.55)#	239.18'	

Describe in detail the manner in which the well was plugged, indicating where the mud fluid was placed and the method or methods used in introducing it into the hole. If cement or other plugs were used, state the character of same and depth placed, from _____ feet to _____ feet for each plug set.

Filled with drilling mud to 242'. Drove plug to 242'. Put in 15 sacks cement then pumped full of mud 25' from top of hole. Drove plug down to 25' then filled to top with 10 sacks of cement.

(If additional description is necessary, use BACK of this sheet)

Correspondence regarding this well should be addressed to D. G. Hansen
Address 206 Union National Bank Bldg. Logan, Kansas

STATE OF Kansas, COUNTY OF Sedgwick, ss.
R. A. Cook (employee of owner) or ~~owner~~ of the above-described well,

being first duly sworn on oath, says: That I have knowledge of the facts, statements, and matters herein contained and the log of the above-described well as filed and that the same are true and correct. So help me God.

(Signature) R. A. Cook
206 Union National Bank Bldg.
(Address)

SUBSCRIBED AND SWORN TO before me this 15th day of August, 1951.

My commission expires 8-11-54

A. L. L. L. L.
Notary Public.

PLUGGING
FILE SEC-18 T-9 R-200
BOOK PAGE 103 LINE 13

CONTRACTOR'S WELL LOG

Operator D-G Hansen Farm Name Miller #1
 Location SW SW NW Sec. 18-9S-20W
 Pool Name Morel, East County Rooks State Kansas
 Commencement Date 8-4-51 Completion Date 8-14-51

LOG OF WELL

Elevation 2174 R. B.
 All Measurements from the top of rotary bushing.


DEPTH	FORMATION	DEVIATION FROM VERTICAL	REMARKS:
FROM	TO		
0	240		
240	650		Shale
650	1155		Shale & Sand
1155	1240		Sand
1240	1400		Sand
1400	1575	1500-0°	Shale
1575	1665		Red Bed
1665	1690		Anhy.
1690	1705		Anhy.
1705	2020		Shale
2020	2200		Shale-Lime
2200	2315		Lime-Shale
2315	2430		Lime-Shale
2430	2500	2500-0°	Lime-Shale
2500	2580		Lime-Shale
2580	2700		Lime-Shale
2700	2810		Lime-Shale
2810	2890		Lime-Shale
2890	3010	3000-0°	Lime-Shale
3010	3105		Lime-Shale
3105	3175		Lime-Shale
3175	3275		Lime-Shale
3275	3390		Lime-Shale
3390	3430		Lime
3430	3500	3500-0°	Lime
3500	3555		Lime
3555	3590		Lime
3590	3635		Lime
3635	3715		Lime
3715	3740		Lime
3740	3743		Chert
3743	3775		Chert
3775	3779		T.D.

CASING LEFT IN HOLE AFTER COMPLETION

Ran 239.18' (8 jts.) of 8 5/8" O D Casing

STATE OF KANSAS, COUNTY OF SEDGWICK)SS

The undersigned certifies that to the best of his knowledge and belief, the above facts are true and correct.

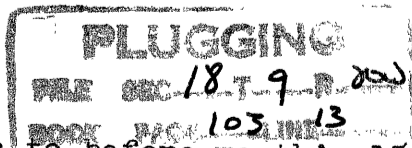

C-G DRILLING CO.

By R. A. Cook

President

1951

Subscribed and sworn to before me this 15th day of August, 1951

My commission expires: August 11, 1954

Almeda Rowe
 Notary Public