


STATE OF KANSAS
STATE CORPORATION COMMISSION

Form CP-4

Give All Information Completely
Make Required Affidavit
Mail or Deliver Report to:
Conservation Division
State Corporation Commission
211 No. Broadway
Wichita, Kansas

WELL PLUGGING RECORD

NORTH

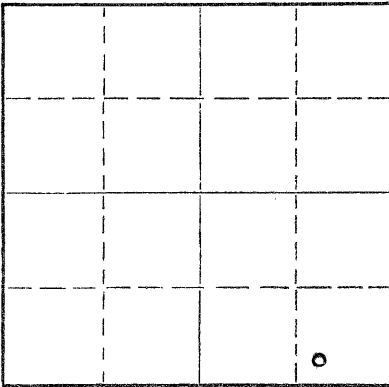

Locate well correctly on above
Section Plat

Rooks

County. Sec. 29 Twp. 9S Rge. (E) 20 (W)

Location as "NE/CNW/SW" or footage from lines SW SE SE

Lease Owner Petroleum Operating Company

Lease Name HASE

Well No. 1

Office Address P.O. Box 7027, Tulsa, Oklahoma

Character of Well (completed as Oil, Gas or Dry Hole) Dry Hole

Date well completed 12-15-1962

Application for plugging filed 12-15-1962

Application for plugging approved 12-15-1962

Plugging commenced 12-15-1962

Plugging completed 12-15-1962

Reason for abandonment of well or producing formation Dry Hole

If a producing well is abandoned, date of last production 19

Was permission obtained from the Conservation Division or its agents before plugging was commenced? Yes

Name of Conservation Agent who supervised plugging of this well Eldon Petty

Producing formation Dry Hole Depth to top Bottom Total Depth of Well 3893 Feet

Show depth and thickness of all water, oil and gas formations.

OIL, GAS OR WATER RECORDS

CASING RECORD

FORMATION	CONTENT	FROM	TO	SIZE	PUT IN	PULLED OUT
Lansing	Water	3578	3803	8 5/8"	219'	None

Describe in detail the manner in which the well was plugged, indicating where the mud fluid was placed and the method or methods used in introducing it into the hole. If cement or other plugs were used, state the character of same and depth placed, from feet to feet for each plug set.

Bottom plug at 480' w/20 sax cement

Middle plug at 200' w/20 sax cement

Top plug at 40' w/10 sax cement

RECEIVED
STATE CORPORATION COMMISSION

JAN 4 1963

1-4-63

CONSERVATION DIVISION
WICHITA, KANSAS

(If additional description is necessary, use BACK of this sheet)

Name of Plugging Contractor Rotary well drilled - no pipe set

Address

STATE OF OKLAHOMA, COUNTY OF TULSA, ss.
Joseph Teichman (employee or owner) or (owner or operator) of the above-described

well, being first duly sworn on oath, says: That I have knowledge of the facts, statements, and matters herein contained and the log of the above-described well as filed and that the same are true and correct. So help me God.

(Signature)

P.O. Box 7027, Tulsa, Oklahoma

(Address)

SUBSCRIBED AND SWORN to before me this 31st day of December, 1962

My commission expires 3-17-64

Notary Public.

SHOLOM DRILLING COMPANY, INC.
P.O. Box 7027
Tulsa, Oklahoma

FORMATION LOG

COMPANY: Petroleum Operating Company
FARM: HASE #1
LOCATION: SW SE SE Sec. 29-T9S-R20W - Rooks County, Kansas
ROTARY DRILLING CONTRACTOR: Sholom Drilling Company, Inc.

COMMENCED: 12-7-62
COMPLETED: 12-15-62
I.P.: D & A

Elevation: 2273' K.B.
Rotary TD: 3893'

Casing Record:
8-5/8" @ 219' w/150 sax

LOG

70	=	70	Clay & Sand
212	-	212	Shale
219	-	219	Plug & Cement
219	-	540	Shale
540	-	1195	Shale & Sand
1195	-	1360	Sand
1360	-	1480	Shale & Sand
1480	-	1775	Red Bed
1775	-	1816	Anhydrite
1816	-	2225	Shale & Shells
2225	-	3430	Lime & Shale
3430	-	3483	Lime
3483	-	3585	Lime & Shale
3585	-	3855	Lime
3855	-	3893	Lime & Conglomerate

Anhydrite	1775-1816 (driller)
Topeka	3326'
Heebner	3537'
Toronto	3556'
Lansing	3578'
Base K.C.	3803'
Marmaton	3813'
Conglomerate	3853'
Rotary Total	
Depth	3893'

STATE OF OKLAHOMA

JAN 4 1963

COMBINATION DRILLING
NOTARY PUBLIC

STATE OF OKLAHOMA)
COUNTY OF TULSA) ss.

I, Joseph Teichman, President of Sholom Drilling Company, Inc. a corporation of the State of Oklahoma, domesticated in the State of Kansas, being first duly sworn under oath, says: That I have knowledge of the facts, statements and matters herein contained of the above described well as filed and that the same are true and correct.


Joseph Teichman

Subscribed and sworn to before me this 31st day of December, 1962.


Notary Public

My commission expires: 3-17-62