

STATE OF KANSAS
STATE CORPORATION COMMISSION

WELL PLUGGING RECORD

Give All Information Completely
Make Required Affidavit
Mail or Deliver Report to
Conservation Division
State Corporation Comm.
200 Colorado Derby Bldg.
202 W. 1st St.
Wichita, KS 67202

Rooks County Sec. 29 Twp. 9s Rge. 20 W
Location as "NE/CNW/SW" or footage from lines _____

900' FNL 990' FEL SE 1/4
Lease Owner Wamego Oil, Inc.

Lease Name Lambert Well No. #1

Office Address 200 Research Drive, Suite G
Manhattan, Kansas 66502

Character of Well (Completed as Oil, Gas or Dry Hole) _____
Dry Hole

Date Well completed February 2 1982

Application for plugging filed February 2 1982

Application for plugging approved February 2 1982

Plugging commenced 10:45 P.M. February 2 1982

Plugging completed 12:00 P.M. February 2 1982


Reason for abandonment of well or producing formation _____
No Commercial Production

If a producing well is abandoned, date of last production _____
19

Was permission obtained from the Conservation Division or its agents before plugging was commenced? Yes

Name of Conservation Agent who supervised plugging of this well Marion Schmidt
Producing formation _____ Depth to top _____ Bottom _____ Tl. Depth of Well _____

Show depth and thickness of all water, oil and gas formations.

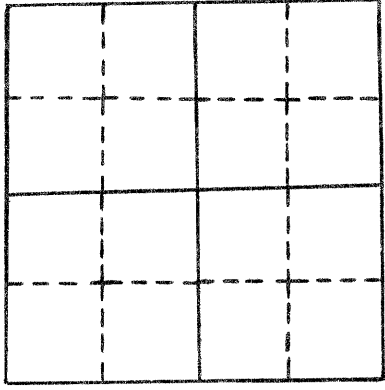

locate well correctly
on above
Section Plot

OIL, GAS OR WATER RECORDS

CASING RECORD

FORMATION	CONTENT	FROM	TO	SIZE	PUT IN	PULLED OUT
Surface Casing	common	0'	250'	8 5/8"	250'	0'

Describe in detail the manner in which the well was plugged, indicating where the mud fluid was placed and the method or methods used in introducing it into the hold. If cement or other plugs were used, state the character of same and depth placed, from _____ feet to _____ feet for each plug set.

Plug #1 985' with 70sxs

Plug #2 230' with 40sxs

Plug #3 40' with 10sxs

10sxs in rathole

Total----130sxs 50-50 pos 4%gel 3%cc


P.D @ 12:00 P.M. 2-2-82

(If additional description is necessary, use BACK of this sheet)

Name of Plugging Contractor Pioneer Drilling Company
308 West Mill Plainville, Ks 67663

STATE OF Kansas COUNTY OF Geary, ss.

Harold G. Sadowski (~~employee of owner~~) or (owner or operator) of the above described well, being first duly sworn on oath, says: That I have knowledge of the facts, statements, and matters herein, and the log of the above described well is filed and that the same are true and correct. **RECEIVED** help me God.

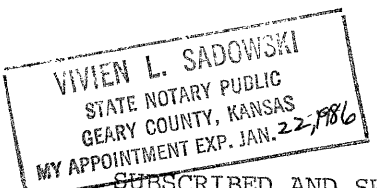

(Signature) Harold G. Sadowski
3-12-82
CONSERVATION DIVISION
Wichita, Kansas

SUBSCRIBED AND SWORN TO before me this 10th day of March, 1982

My commission expires Jan. 22, 1986 Vivien L. Sadowski
Notary Public