


STATE OF KANSAS
STATE CORPORATION COMMISSION

WELL PLUGGING RECORD

Give All Information Completely
Make Required Affidavit
Mail or Deliver Report to:
Conservation Division
State Corporation Commission
800 Bitting Building
Wichita, Kansas

ROOKS County, Sec. 29 Twp. 9 Rge. 20 (E) W (W)
Location as "NE/CNW $\frac{1}{4}$ SW $\frac{1}{4}$ " or footage from lines NE Cor SE $\frac{1}{4}$
Lease Owner Nadel and Gussman
Lease Name Christine Well No. 1
Office Address Drawer 309, Tulsa, Oklahoma
Character of Well (completed as Oil, Gas or Dry Hole) Dry
Date well completed 6-28-50
Application for plugging filed 6-28-50
Application for plugging approved 6-28-50
Plugging commenced 6-28-50
Plugging completed 6-28-50
Reason for abandonment of well or producing formation Dry

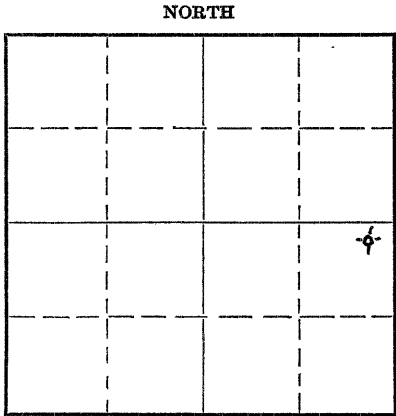

Locate well correctly on above
Section Plat

If a producing well is abandoned, date of last production 19...
Was permission obtained from the Conservation Division or its agents before plugging was commenced? Yes

Name of Conservation Agent who supervised plugging of this well Mr. Petty
Producing formation Depth to top Bottom Total Depth of Well 3914 Feet
Show depth and thickness of all water, oil and gas formations.

OIL, GAS OR WATER RECORDS

CASING RECORD

Formation	Content	From	To	Size	Put In	Pulled Out
				8-5/8	164	0

Describe in detail the manner in which the well was plugged, indicating where the mud fluid was placed and the method or methods used in introducing it into the hole. If cement or other plugs were used, state the character of same and depth placed, from feet to feet for each plug set.

Hole filled with heavy mud from 3914 to 164'; 15 sacks cement @ 164 - mud to surface and 10 sacks cement in top of casing

RECEIVED
Conservation Div.
7/12/50
JUL 12 1950
STATE CORPORATION COMMISSION
KANSAS

(If additional description is necessary, use BACK of this sheet)
Correspondence regarding this well should be addressed to Nadel and Gussman
Address Drawer 309, Tulsa, Oklahoma

STATE OF KANSAS, COUNTY OF SEDGWICK, ss.
L. C. Hay (employee of owner) or (owner or operator) of the above-described well,
being first duly sworn on oath, says: That I have knowledge of the facts, statements, and matters herein contained and the log of the above-described well as filed and that the same are true and correct. So help me God.

(Signature) L. C. Hay
Union National Bank Bldg., Wichita, Kansas
(Address)

SUBSCRIBED AND SWORN TO before me this 29th day of June, 1950
Notary Public.

My commission expires Nov. 3, 1952

28-3273-s 4-50-10M
PLUGGING
JUN 29 9 20 AM '50
13 44

WELL LOG

NADEL AND GUSSMAN

CHRISTINE No. 1

NE Cor SE/4 29-9-20W
Rooks County, Kansas

Comm. 6-18-50
Comp. 6-28-50

Csg. 8-5/8" @ 164.22 v/125 Sax
Elev. 2275

Formations

Sand and clay	80
Shale and shells	465
Shale-Sand-Shells	1255
Sand	1500
Shale	1765
Anhydrite	1810
Shale-Red Bed-Shells	2070
Shale-shells	2255
Shale-lime	2655
Florence Flint	2675
Shale and lime	3425
Lime	3488
Lime and Shale	3557
Lime	3800
Conglomerate	3823
Shale and Lime	3883
Shale	3907
Chert - White	3914
T.D.	3914

Tops

Topeka	3313
Heebner	3523
Toronto	3544
Lansing-K.C.	3562
Shaly Conglomerate	3854
White Chert	3907

STATE OF KANSAS

COUNTY OF SEDGWICK

} SS

Nole Babb, of lawful age, being first duly sworn deposes and states that the above formations and depths are true and correct as taken from the daily drilling log of the Christine No. 1 well located in the NE Corner of the SE/4 of 29-9-20W, Rooks County, Kansas.

Nole Babb

Subscribed and sworn to before me this 10th day of July, 1950.

Barney Rogers
Notary Public

My commission expires February 10, 1954

PLUGGING
FILE SEC 29 9 20W
BOOK PAGE 13 LINE 40

7/12/50
NOTARY PUBLIC
COMMISSION
KANSAS