

STATE OF KANSAS
STATE CORPORATION COMMISSION

Form CP-4

WELL PLUGGING RECORD

Give All Information Completely
Make Required Affidavit
Mail or Deliver Report to:
Conservation Division
State Corporation Commission
212 No. Market
Wichita, Kansas

Rocks _____ County. Sec. 28 Twp. 9 Rge. 20 (E) _____ (W) X

Location as "NE/CNW%SW%" or footage from lines _____ NW SW

Lease Owner Nadel & Gussman

Lease Name Kern Well No. 1

Office Address P. O. Box 158 Plainville, Kansas

Character of Well (completed as Oil, Gas or Dry Hole) _____

Date well completed _____ 19 _____

Application for plugging filed 11-4-66 _____ 19 _____

Application for plugging approved 11-5-66 _____ 19 _____


Plugging commenced 12-1-66 _____ 19 _____

Plugging completed 12-6-66 _____ 19 _____

Reason for abandonment of well or producing formation _____

If a producing well is abandoned, date of last production _____ 19 _____

Was permission obtained from the Conservation Division or its agents before plugging was commenced? Yes

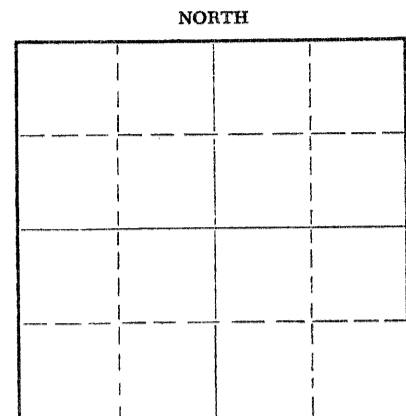

Locate well correctly on above Section Flat

Name of Conservation Agent who supervised plugging of this well Leo F. Massey

Producing formation _____ Depth to top _____ Bottom _____ Total Depth of Well 3859 Feet

Show depth and thickness of all water, oil and gas formations.

OIL, GAS OR WATER RECORDS

CASING RECORD

FORMATION	CONTENT	FROM	TO	SIZE	PUT IN	PULLED OUT
				8 5/8	154	None
				5 1/2	None	1129

Describe in detail the manner in which the well was plugged, indicating where the mud fluid was placed and the method or methods used in introducing it into the hole. If cement or other plugs were used, state the character of same and depth placed, from _____ feet to _____ feet for each plug set.

Moved in.

Rigged up. Took casing off slips. Worked pipe - had 8" tension at 22 joints. Checked sand bridge at 3829'. Mixed and dumped 5 sacks of cement on sand bridge at 3829'. Shot pipe at 914' and 800'. Pulling pipe.

Plugged well with 20 sacks of gel and 70 sacks of cement.

RECEIVED
STATE CORPORATION COMMISSION
DEC 19 1966
12-19-66
CONSERVATION DIVISION
Wichita, Kansas

(If additional description is necessary, use BACK of this sheet)

Name of Plugging Contractor Forbes Casing Pulling, Inc.

Address P. O. Box 221 Great Bend, Kansas

STATE OF Kansas, COUNTY OF Barton, ss.

J. O. Forbes (employee of owner) or (owner or operator) of the above-described well, being first duly sworn on oath, says: That I have knowledge of the facts, statements, and matters herein contained and the log of the above-described well as filed and that the same are true and correct. So help me God.

(Signature) J. O. Forbes

P. O. Box 221 Great Bend, Kansas

(Address)

SUBSCRIBED AND SWORN TO before me this 16 day of December, 19 66

My commission expires May 27, 1969

Notary Public.

RESERVE DRILLING COMPANY, INC.

KERN No. 1 NW SW 28-9-20W
Rooks County, Kansas

Comm. 4- 1-50
Comp. 4-11-50

Casing: 154' 8-5/8" w/110 sax cem.
3856' 5-1/2" w/125 sax cem.

Elevation 2279' Rotary Bushing

Shale and Shells	700
Shale and sand	1215
Shale	1235
Sand	1480
Shale and shells	1750
Shale	1765
Anhydrite	1810
Shale and shells	2215
Broken Lime	2345
Lime	2455
Shale and Lime	2640
Lime	2700
Shale and Lime	3358
Lime	3413
Shale and Lime	3490
Lime	3809
Conglomerate	3837
Shale and sand	3845
Shale	3855
Arbuckle	3859 T.D.

Geological Tops

Topeka	3310
Heebner	3517
Toronto	3527
Lansing-Kansas City	3555
Simp. Dolomite	3846
Arb. Dolomite	3855

RECEIVED
OIL AND GAS CORPORATION COMMISSION

NOV 7 1966

CONSERVATION DIVISION
WARRANT OFFICE

State of Kansas)
County of Sedgwick) ss:

L. C. Hay of lawful age being first duly sworn states that the above formations and depths are true and correct as taken from the daily drilling log on the Kern No. 1 well located in the NW SW of 28-98-20W, Rooks County, Kansas.

L. C. Hay

Subscribed and sworn to before me this 19th day of April, 1950.

W. C. Barry
Notary Public

My commission expires Nov. 3, 1952