

STATE OF KANSAS  
STATE CORPORATION COMMISSION


Form CP-4

WELL PLUGGING RECORD

Give All Information Completely  
Make Required Affidavit  
Mail or Deliver Report to:  
Conservation Division  
State Corporation Commission  
212 No. Market  
Wichita, Kansas

Rooks County. Sec. 28 Twp. 9 Rge. 20 (E) (W) X

NORTH

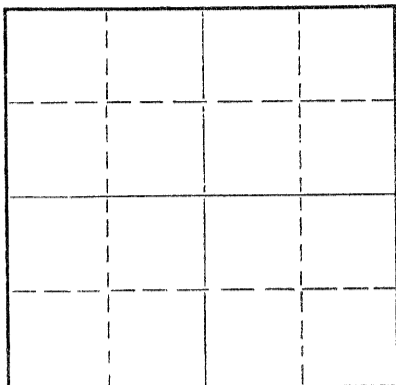

Locate well correctly on above  
Section Plat

Location as "NE/CNW/SW" or footage from lines NE SW SW  
Lease Owner Nadel & Gussman  
Lease Name Kern Well No. 6  
Office Address P. O. Box 158 Plainville, Kansas  
Character of Well (completed as Oil, Gas or Dry Hole) \_\_\_\_\_  
Date well completed \_\_\_\_\_ 19\_\_\_\_  
Application for plugging filed 11-1-66 19\_\_\_\_  
Application for plugging approved 11-5-66 19\_\_\_\_  
Plugging commenced 11-16-66 19\_\_\_\_  
Plugging completed 12-6-66 19\_\_\_\_  
Reason for abandonment of well or producing formation \_\_\_\_\_

If a producing well is abandoned, date of last production \_\_\_\_\_ 19\_\_\_\_  
Was permission obtained from the Conservation Division or its agents before plugging was commenced? Yes

Name of Conservation Agent who supervised plugging of this well Leo F. Massey  
Producing formation \_\_\_\_\_ Depth to top \_\_\_\_\_ Bottom \_\_\_\_\_ Total Depth of Well 3896 Feet  
Show depth and thickness of all water, oil and gas formations.

OIL, GAS OR WATER RECORDS

CASING RECORD

FORMATION	CONTENT	FROM	TO	SIZE	PUT IN	PULLED OUT
				8 5/8	112	None
				5 1/2	None	599

Describe in detail the manner in which the well was plugged, indicating where the mud fluid was placed and the method or methods used in introducing it into the hole. If cement or other plugs were used, state the character of same and depth placed, from \_\_\_\_\_ feet to \_\_\_\_\_ feet for each plug set.

Cleaned out cellar. Broke off tubing head.

Sanded back to 3866'. Mixed and dumped 5 sacks of cement on sand bridge at 3866'. Rigged up. Shot casing at 1010' - 811' and 600'.

Pulling pipe.

Plugged well with 16 sacks of gel and 70 sacks of cement.

RECEIVED  
STATE CORPORATION COMMISSION

DEC 19 1966

12-19-66

CONSERVATION DIVISION  
Wichita, Kansas

(If additional description is necessary, use BACK of this sheet)

Name of Plugging Contractor Forbes Casing Pulling, Inc.  
Address P. O. Box 221 Great Bend, Kansas

STATE OF Kansas, COUNTY OF Barton, ss.  
J. O. Forbes (employee of owner) or (owner or operator) of the above-described

well, being first duly sworn on oath, says: That I have knowledge of the facts, statements, and matters herein contained and the log of the above-described well as filed and that the same are true and correct. So help me God.

(Signature) J. O. Forbes  
P. O. Box 221 Great Bend, Kansas  
(Address)

SUBSCRIBED AND SWORN TO before me this 16 day of December, 19 66

My commission expires May 27, 1969

Notary Public.

NADEL AND GUSSMAN

KERN No. 6

NE SW SW 28-9-20W  
Rooks County, Kansas

Comm: 1-21-52  
Comp: 1-31-52

Casing: 8-5/8" 142' v/100 saz  
5-1/2" 3892 1/2' v/100 saz

Formations	Depth
Clay, sand, shale	152
Shale, shells and sand	1300
Shale, shells, sand, red bed	1786
Anhydrite	1830
Shale, shells	2000
Broken lime and shale	2305
Broken lime	2405
Lime and shale	3300
Lime	3374
Lime and shale	3588
Lime	3624
Lime and shale	3669
Lime	3765
Lime and shale	3830
Lime, Cong.	3877
Shale	3892
Arbuckle Dolomite	3895

Geological Tops

Heebner	3549'
Dodge	3569'
Lansing-K.C.	3588 (-1283)
E. Kansas City	3813'
Conglomerate	3873'
Simpson Shale	3882'
Arbuckle	3892 (-1587)

T.P. 30612  
 RECORDED  
 NOV 7 1952  
 CONSERVATION DIVISION  
 STATE OF KANSAS

STATE OF KANSAS }  
 COUNTY OF SEDGWICK } SS:

L. C. Hay, of lawful age, deposes and states that the above formations and depths are correct as shown by the daily drilling log of the Kern Well No. 6 in the NE SW SW 28-9-20W, Rooks County, Kansas.

L. C. Hay

Subscribed and sworn to before me this 5th day of February, 1952.

Nola Bales  
 Notary Public

My commission expires Nov. 3, 1952