

STATE OF KANSAS
STATE CORPORATION COMMISSION

WELL PLUGGING RECORD

Give All Information Completely
Make Required Affidavit
Mail or Deliver Report to:
Conservation Division
State Corporation Commission
800 Bitting Building
Wichita, Kansas

Rooks County. Sec. **28** Twp. **9** Rge. **20** (E) **N** (W)

Location as "NE/CNW $\frac{1}{4}$ SW $\frac{1}{4}$ " or footage from lines **330 N 660 E NW corner NW/4**

Lease Owner **Nadel and Gussman**

Lease Name **Myrtle** Well No. **1**

Office Address **Box 309, Tulsa, Okla**

Character of Well (completed as Oil, Gas or Dry Hole) **dry**

Date well completed **7-18 1950**

Application for plugging filed **7-18 1950**

Application for plugging approved **7-18 1950**


Plugging commenced **7-18 1950**

Plugging completed **7-18 1950**

Reason for abandonment of well or producing formation **Dry**

If a producing well is abandoned, date of last production _____ 19__

Was permission obtained from the Conservation Division or its agents before plugging was commenced? **Yes**

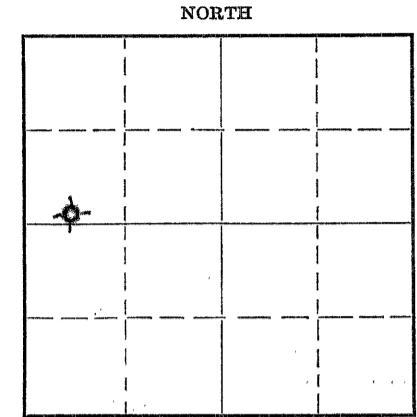

Locate well correctly on above Section Flat

Name of Conservation Agent who supervised plugging of this well **Petty**

Producing formation _____ Depth to top _____ Bottom _____ Total Depth of Well **3900** Feet

Show depth and thickness of all water, oil and gas formations.


OIL, GAS OR WATER RECORDS

CASING RECORD

Formation	Content	From	To	Size	Put In	Pulled Out
				8-5/8"	131'	None

Describe in detail the manner in which the well was plugged, indicating where the mud fluid was placed and the method or methods used in introducing it into the hole. If cement or other plugs were used, state the character of same and depth placed, from _____ feet to _____ feet for each plug set.

Hole filled with heavy mud from 3900 to 131' 15 sacks cement at 131' to 35' 10 sacks cement 35' to top of hole

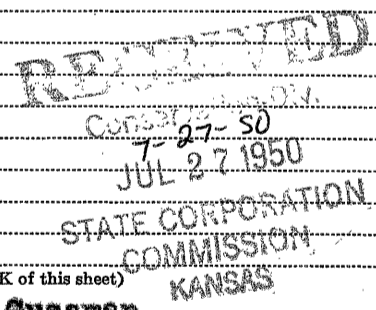

(If additional description is necessary, use BACK of this sheet)

Correspondence regarding this well should be addressed to **Nadel and Gussman**
Address **P. O. Box 309, Tulsa, Oklahoma**

STATE OF **KANSAS**, COUNTY OF **SEDGWICK**, ss.

L. C. Hay (employee of owner) or (owner or operator) of the above-described well, being first duly sworn on oath, says: That I have knowledge of the facts, statements, and matters herein contained and the log of the above-described well as filed and that the same are true and correct. So help me God.

(Signature) **L. C. Hay**

703 Union Natl Bank Bldg. Wichita, Kans.

SUBSCRIBED AND SWORN to before me this **19th** day of **July**, 19**50**

My commission expires **Nov. 3, 1952** **Notary Public.**

PLUGGING
FILE SEC 28 T 9 R 20W
BOOK PAGE 17 LINE 19

15-163-02546-00-00

WELL LOG

Nadel and Gussman

Myrtle No. 1

330' No. 660' E SW NW
28-9-20W - Rooks County
Kansas

Comm: 7-5-50
Comp: 7-18-50

Casing - 131' 8-5/8" Cst
w/110 sac cement

Formations	Depths
Clay, sand, shale	131
Shale	705
Shale and sand	1125
Shale, sand, rock	1270
Sand	1510
Shale	1705
Shale and shells	1780
Anhydrite	1825
Shale and shells	2240
Broken lime	2275
Lime and shale	2395
Broken lime	2520
Lime	2560
Lime and shale	2670
Shale and shells	2920
Shale and lime	3275
Lime	3338
Lime and shale	3403
Lime	3543
Lime and shale	3570
Lime	3803
Shale	3811
Lime	3825
Shale	3857
Conglomerate	3891
Shale	3900 T.D.

Tops	
Heebner Shale	3537
Toronto Limestone	3557
Lansing-Kansas City	3576
Basal Penna Congl.	3860
to Total Depth	3900'

STATE OF KANSAS }
COUNTY OF SEDGWICK } SS:

L. C. Hay, of lawful age, deposes and states that the above formations and depths are true and correct as taken from the daily drilling log of the Myrtle No. 1 well in the SW NW of Sec. 28-9-20W, Rooks County, Kansas.

PLUGGING *L. C. Hay*
WELL SEC 28 T 9 R 20W

Subscribed and sworn to before me this 17th day of July, 1950.

John Barr

My commission expires Nov. 3, 1952