

STATE OF KANSAS
STATE CORPORATION COMMISSION

WELL PLUGGING RECORD


Give All Information Completely
Make Required Affidavit
Mail or Deliver Report to:
Conservation Division
State Corporation Commission
800 Bitting Building
Wichita, Kansas

OR
FORMATION PLUGGING RECORD

Strike out upper line
when reporting plug-
ging off formations.

Rooks County. Sec. 28 Twp. 9S Rge. 20 (E) W (W)
Location as "NE 1/4 NW 1/4 SW 1/4" or footage from lines. ~~E 1/2 NW 1/4~~ NE NE SE
Lease Owner. Honaker Drilling Co., Inc., et al
Lease Name. Remington Well No. 1
Office Address. 2008 Lakin, Great Bend, Kansas
Character of Well (completed as Oil, Gas or Dry Hole). Dry Hole
Date well completed. 7-5-50 19 50
Application for plugging filed. 7-5 19 50
Application for plugging approved. 7-5 19 50
Plugging commenced. 7-6 19 50
Plugging completed. 7-6 19 50
Reason for abandonment of well or producing formation. Dry

NORTH

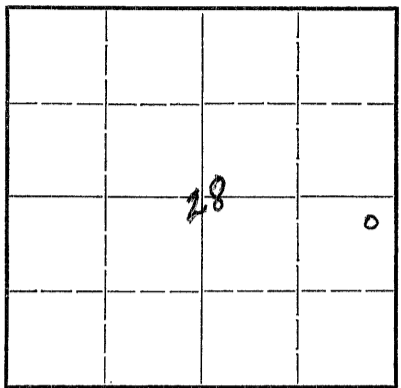

Locate well correctly on above
Section Plat

Name of Conservation Agent who supervised plugging of this well. Eldon Petty
Producing formation. None Depth to top. Bottom. Total Depth of Well. 3868' Feet
Show depth and thickness of all water, oil and gas formations.


OIL, GAS OR WATER RECORDS

CASING RECORD

Formation	Content	From	To	Size	Put In	Pulled Out

Describe in detail the manner in which the well was plugged, indicating where the mud fluid was placed and the method or methods used in introducing it into the hole. If cement or other plugs were used, state the character of same and depth placed, from feet to feet for each plug set.

Hole filled with heavy mud, Halliburton plug placed at 150', 15 sacks cement (hand mixed in bbl.) poured thru drill pipe. Filled with heavy mud to 35' and another Halliburton plug set, 10 sacks cement run and pipe cut off 3' below ground level.

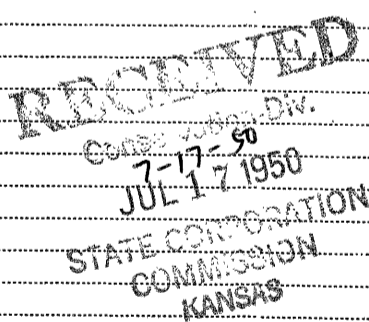

(If additional description is necessary, use BACK of this sheet)

Correspondence regarding this well should be addressed to Honaker Drilling Co., Inc.
Address. 2008 Lakin, Great Bend, Kansas

STATE OF Kansas, COUNTY OF Barton, ss.
C. L. Miles (employee of owner) or (owner or operator) of the above-described well,
being first duly sworn on oath, says: That I have knowledge of the facts, statements, and matters herein contained and the log of the above-described well as filed and that the same are true and correct. So help me God.

(Signature) C. L. Miles

Great Bend, Kansas
(Address)

SUBSCRIBED AND SWORN to before me this 14th day of July, 1950

Erna P. Mansel
Notary Public.

My commission expires January 19, 1952

PLUGGING
FILE SEC 28 T 9 R 20W
BOOK PAGE 15 LINE 8

DRILLER'S LOG

15-163-02475-00-00

Operator Honaker Drilling Co., Inc., et al

Contractor Honaker Drilling Co., Inc.

Lease Amington #1

Further Description NE NE SE of Section 26-25-20W, Rocks County, Kansas

	<u>From</u>	<u>To</u>		<u>From</u>	<u>To</u>
Soil & Sand	0	50	Shale	1505	1575
Shale & Sand	50	120	Shale & Shells	1575	1750
Shale & Shells	120	160	Red Bed & Shells	1750	1772
Run 160' 8-5/8" casing, cemented with 100 sacks cement, 100# Gal.			Anhydrite	1772	1804
Shale & Sand	160	300	Shale & Shells	1804	2110
Sand	300	350	Shale & Red Bed	2110	2280
Shale	350	600	Lime & Shale	2280	2500
Shale & Shells	600	820	Lime	2500	2615
Lime	820	880	Lime & Shale	2615	2600
Sand	880	1005	Lime	2600	2700
Shale	1005	1075	Lime & Shale	2700	3515
Shale & Shells	1075	1300	Lime	3515	3515
Sand	1300	1505	Lime & Shale	3515	3675
			Lime	3675	3800

T. D. 2808'

(Above depths are Rotary Bushing Measurements,
less 4' to ground level)

The foregoing is correct to the best of my knowledge.

HONAKER DRILLING CO., INC.

By _____
President

RECEIVED

Conservation Div.

JUL 17 1950

STATE CORPORATION
COMMISSION
KANSAS

PLUGGING
FILE SEC 28 Y 9 200
BOOK PAGE 15 OF 8