


STATE OF KANSAS  
STATE CORPORATION COMMISSION

Form CP-4

Give All Information Completely  
Make Required Affidavit  
Mail or Deliver Report to:  
Conservation Division  
State Corporation Commission  
211 No. Broadway  
Wichita, Kansas

WELL PLUGGING RECORD

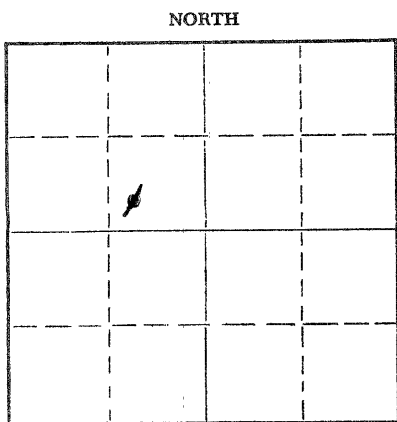

Locate well correctly on above  
Section Plat

Rooks \_\_\_\_\_ County. Sec. 28 Twp. 9S Rge. \_\_\_\_\_ (E) 20W (W)  
Location as "NE/CNW/SW" or footage from lines SW $\frac{1}{4}$  SE $\frac{1}{4}$  NW $\frac{1}{4}$   
Lease Owner Birmingham-Bartlett Drilling Co.  
Lease Name Renner Well No. 1  
Office Address 300 Kaufman Building, Wichita, Kansas, 67202  
Character of Well (completed as Oil, Gas or Dry Hole) Oil Well  
Date well completed February 19, 19 59  
Application for plugging filed April 6, 19 66  
Application for plugging approved April 7, 19 66  
Plugging commenced May 2 19 66  
Plugging completed May 5 19 66  
Reason for abandonment of well or producing formation Production declined to a point where well no longer economical to operate.  
If a producing well is abandoned, date of last production April 1, 19 66  
Was permission obtained from the Conservation Division or its agents before plugging was commenced? Yes

Name of Conservation Agent who supervised plugging of this well Leo Massey  
Producing formation Arbuckle Depth to top 3868 Bottom \_\_\_\_\_ Total Depth of Well 3880 Feet  
Show depth and thickness of all water, oil and gas formations.

OIL, GAS OR WATER RECORDS

CASING RECORD

FORMATION	CONTENT	FROM	TO	SIZE	PUT IN	PULLED OUT
		0	232	8-5/8"	232	None
		0	3869'	5-1/2"	3869'	1520.66'

Describe in detail the manner in which the well was plugged, indicating where the mud fluid was placed and the method or methods used in introducing it into the hole. If cement or other plugs were used, state the character of same and depth placed, from \_\_\_\_\_ feet to \_\_\_\_\_ feet for each plug set.

3880' - 3850' - Sand  
3850' - 3810' - 5 Sacks Cement  
3810' - 235' - Mud  
235' - 225' - Rock Bridge  
225' - 207' - 6 Sacks cement with 2 gal. calcium chloride  
207' - BASE - 3 yds. Ready-Mix Cement

RECEIVED  
STATE CORPORATION COMMISSION

JUN - 7 1966  
6-7-66  
CONSERVATION DIVISION  
WICHITA, KANSAS

(If additional description is necessary, use BACK of this sheet)

Name of Plugging Contractor Santa-Fe Pipe & Supply, Inc.  
Address Box 562, Great Bend, Kansas 67530

STATE OF KANSAS COUNTY OF SEDGWICK  
Chas. H. Keevert, Production Supt. of Birmingham-Bartlett Drilling Co. ss.  
(employee of owner) or (owner or operator) of the above-described well, being first duly sworn on oath, says: That I have knowledge of the facts, statements, and matters herein contained and the log of the above-described well as filed and that the same are true and correct. So help me God.

(Signature) Chas H Keevert  
Route 1, 1806 Tracy Lane, Hutchinson, Kansas  
(Address)

SUBSCRIBED AND SWORN TO before me this 6th day of June 19 66

My commission expires November 29, 1966

Vivian F. Yinger  
Vivian F. Yinger, Notary Public.

RENNER #1 WELL

LOCATION: SW/4 SE/4 NW/4 Sec. 28-98-20W  
Rooks County, Kansas

SPUDDED: 2-4-59  
COMPLETED: 2-13-59

OWNER, OPERATOR and CONTRACTOR: Birmingham-Bartlett Drilling Co.  
300 Kaufman Building  
Wichita 2, Kansas

SURFACE CASING: 8-5/8" used casing cemented at 232' with 140 sacks cement

OIL STRING: 5-1/2" casing cemented at 3069.50' with 75 sacks cement by Sun Cementing Co. Plug pumped to float = 3049'. Spotted 40 sacks MagCohar gel mud through stage collar set in Anhydrite @ 1816'.

LOG

(Figures indicate bottom of formation)

0 -	33	Clay
	115	Clay and Sand
	550	Shale
	950	Shale and Shells
	1250	Shale and Sand
	1430	Sand
	1550	Sand and Shale
	1787	Red Bed and Shale
	1834	Anhydrite
	1895	Red Bed and Shale
	2155	Shale and Shells
	2250	Broken Lims and Shale
	2575	Lime and Shale
	2660	Shale and Shells
	2715	Lime
	3375	Lime and Shale
	3650	Lime
	3868	Stinson
	3872	Arbuckle Lime
	3872	Rotary Total Depth

RECEIVED  
STATE COMMISSIONER

APR 7 1960

COMSERVATION DIVISION  
WICHITA, KANSAS

The undersigned, Richard Hindery, one of the partners of Birmingham-Bartlett Drilling Co., hereby certifies that the above is a true and correct log of the formations encountered in drilling the Renner #1 Well, as shown in the daily drilling reports.

BIRMINGHAM-BARTLETT DRILLING CO.

By Richard Hindery  
Richard Hindery, Partner

Subscribed and sworn to before me  
this 17th day of February, 1959.

Vivian F. Yinger  
Vivian F. Yinger, Notary Public

My commission expires November 29, 1962.