

*Corrected map*

RECEIVED **FIRST CORRECTED**  
KANSAS CORPORATION COMMISSION  
5-24-07 Form C-1  
December 2002  
Form must be Signed  
All blanks must be Filled  
MAY 24 2007  
CONSERVATION DIVISION  
WICHITA, KS

For KCC Use:  
Effective Date: 12-20-06  
District #: 2  
SGA?  Yes  No

KANSAS CORPORATION COMMISSION  
OIL & GAS CONSERVATION DIVISION  
**NOTICE OF INTENT TO DRILL**

Must be approved by KCC five (5) days prior to commencing well

Expected Spud Date December, 16th 2006  
month day year

Spot NWSE  East  
~~6~~ 8/2 NW Sec. 12 Twp. 33 S. R. 2  West  
1650 feet from  N /  S Line of Section  
1650 feet from  E /  W Line of Section

OPERATOR: License# 33830  
Name: Hewitt Energy Group  
Address: 15 W South Temple Suite 1050  
City/State/Zip: Salt Lake City, UT 84101  
Contact Person: Doug Hewitt Jr  
Phone: 801-519-8500

(Note: Locate well on the Section Plat on reverse side)  
County: Sumner  
Lease Name: HEG Whitten Well #: 12-3  
Field Name: Perth

CONTRACTOR: License# 33879  
Name: Field Star Drilling

Is this a Prorated / Spaced Field?  Yes  No  
Target Formation(s): Kansas City, Cottage Grove, Misner, Viola, Simpson, Arbuckle  
Nearest Lease or unit boundary: 1320' W

Well Drilled For: Well Class: Type Equipment:  
 Oil  Enh Rec  Infield  Mud Rotary  
 Gas  Storage  Pool Ext.  Air Rotary  
 OWWO  Disposal  Wildcat  Cable  
 Seismic; # of Holes  Other  
 Other

Ground Surface Elevation: 1221 feet MSL  
Water well within one-quarter mile:  Yes  No  
Public water supply well within one mile:  Yes  No

If OWWO: old well information as follows:  
Operator: \_\_\_\_\_  
Well Name: \_\_\_\_\_  
Original Completion Date: \_\_\_\_\_ Original Total Depth: \_\_\_\_\_

Depth to bottom of fresh water: 230'  
Depth to bottom of usable water: 230'  
Surface Pipe by Alternate:  1  2

Directional, Deviated or Horizontal wellbore?  Yes  No  
If Yes, true vertical depth: \_\_\_\_\_  
Bottom Hole Location: \_\_\_\_\_  
KCC DKT #: \_\_\_\_\_

Length of Surface Pipe Planned to be set: 250' MINIMUM  
Length of Conductor Pipe required: NONE  
Projected Total Depth: 5500'  
Formation at Total Depth: Arbuckle

\* WAS: TYPE: O/G; LOC: NESWNW 1650 FNL, 190 FWL  
\* IS: TYPE: SWD; LOC: NWSE NW 1650 FNL, 1650 FFWL  
AFFIDAVIT

Water Source for Drilling Operations:  
 Well  Farm Pond Other unknown  
DWR Permit #: will apply if needed  
(Note: Apply for Permit with DWR )  
Will Cores be taken?  Yes  No

The undersigned hereby affirms that the drilling, completion and eventual plugging of this well will comply with K.S.A. 55 et. seq.  
It is agreed that the following minimum requirements will be met:

1. Notify the appropriate district office **prior** to spudding of well;
2. A copy of the approved notice of intent to drill **shall be** posted on each drilling rig;
3. The minimum amount of surface pipe as specified below **shall be set** by circulating cement to the top; in all cases surface pipe **shall be set** through all unconsolidated materials plus a minimum of 20 feet into the underlying formation.
4. If the well is dry hole, an agreement between the operator and the district office on plug length and placement is necessary **prior to plugging**;
5. The appropriate district office will be notified before well is either plugged or production casing is cemented in;
6. If an ALTERNATE II COMPLETION, production pipe shall be cemented from below any usable water to surface within **120 days** of spud date.  
Or pursuant to Appendix "B" - Eastern Kansas surface casing order #133,891-C, which applies to the KCC District 3 area, alternate II cementing must be completed within 30 days of the spud date or the well shall be plugged. **In all cases, NOTIFY district office** prior to any cementing.

I hereby certify that the statements made herein are true and to the best of my knowledge and belief.  
Date: 5/22/07 Signature of Operator or Agent: \_\_\_\_\_ Title: agent

For KCC Use ONLY  
API # 15 - 191-22502-00-00  
Conductor pipe required NONE feet  
Minimum surface pipe required 250 feet per Alt. (1)  
Approved by: RCH 12-15-06 / WTHMS-24-07  
This authorization expires: 6-15-07  
(This authorization void if drilling not started within 6 months of approval date.)  
Spud date: \_\_\_\_\_ Agent: \_\_\_\_\_

Remember to:  
- File Drill Pit Application (form CDP-1) with Intent to Drill;  
- File Completion Form ACO-1 within 120 days of spud date;  
- File acreage attribution plat according to field proration orders;  
- Notify appropriate district office 48 hours prior to workover or re-entry;  
- Submit plugging report (CP-4) after plugging is completed;  
- Obtain written approval before disposing or injecting salt water.  
- If this permit has expired (See: authorized expiration date) please check the box below and return to the address below.  
 Well Not Drilled - Permit Expired  
Signature of Operator or Agent: \_\_\_\_\_  
Date: \_\_\_\_\_

12  
33  
2W

**FIRST CORRECTED**  
5-24-07

**IN ALL CASES PLOT THE INTENDED WELL ON THE PLAT BELOW**

MAY 24 2007

*Plat of acreage attributable to a well in a prorated or spaced field*

CONSERVATION DIVISION  
WICHITA, KS

**If the intended well is in a prorated or spaced field, please fully complete this side of the form.** If the intended well is in a prorated or spaced field complete the plat below showing that the well will be properly located in relationship to other wells producing from the common source of supply. Please show all the wells and within 1 mile of the boundaries of the proposed acreage attribution unit for gas wells and within 1/2 mile of the boundaries of the proposed acreage attribution unit for oil wells.

API No. 15 - 191-22502-0000  
Operator: Hewitt Energy Group  
Lease: HEG Whitten  
Well Number: 12-3  
Field: Perth

Location of Well: County: Sumner  
1650 feet from  N /  S Line of Section  
1650 feet from  E /  W Line of Section  
Sec. 12 Twp. 33 S. R. 2  East  West



Number of Acres attributable to well: \_\_\_\_\_  
QTR / QTR / QTR of acreage: C - S/2 - NW

Is Section:  Regular or  Irregular

**If Section is irregular, locate well from nearest corner boundary.**  
Section corner used:  NE  NW  SE  SW

**PLAT**

*(Show location of the well and shade attributable acreage for prorated or spaced wells.)  
(Show footage to the nearest lease or unit boundary line.)*

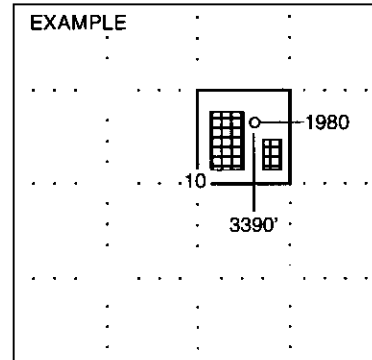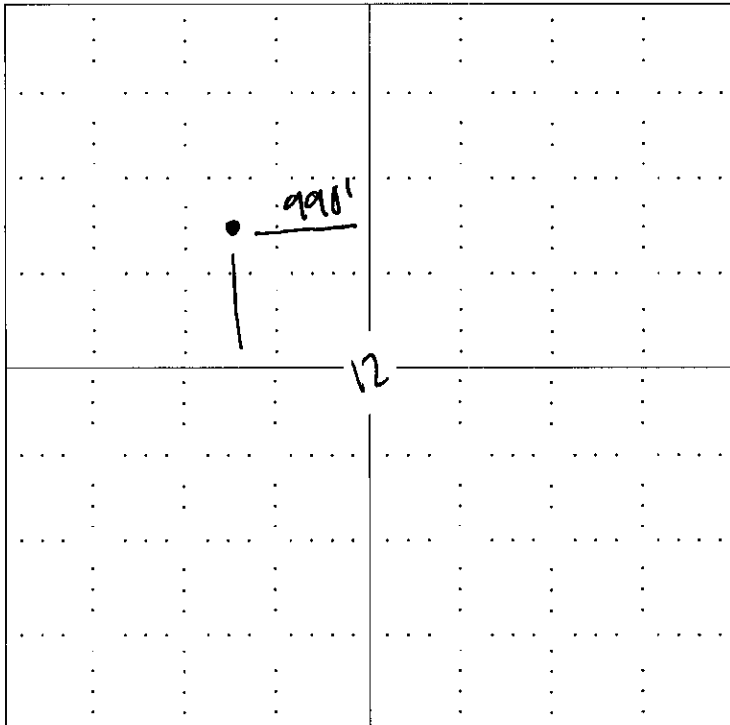

SEWARD CO.

**NOTE: In all cases locate the spot of the proposed drilling location.**

**In plotting the proposed location of the well, you must show:**

1. The manner in which you are using the depicted plat by identifying section lines, i.e. 1 section, 1 section with 8 surrounding sections, 4 sections, etc.
2. The distance of the proposed drilling location from the section's south / north and east / west.
3. The distance to the nearest lease or unit boundary line.
4. If proposed location is located within a prorated or spaced field a certificate of acreage attribution plat must be attached: (CO-7 for oil wells; CG-8 for gas wells).

FILED 5-24-07  
**CORRECTED**

RECEIVED  
KANSAS CORPORATION COMMISSION

KANSAS CORPORATION COMMISSION  
OIL & GAS CONSERVATION DIVISION

MAY 24 2007

Form CDP-1  
April 2004

Form must be Typed

**APPLICATION FOR SURFACE PIT** CONSERVATION DIVISION  
WICHITA, KS

Submit in Duplicate

Operator Name: <b>Hewitt Energy Group</b>		License Number: <b>33830</b>
Operator Address: <b>15 W South Temple Suite 1050</b>		
Contact Person: <b>Doug Hewitt Jr</b>		Phone Number: ( <b>801</b> ) <b>519</b> - <b>8500</b>
Lease Name & Well No.: <b>HEG Whitten #12-3</b>		Pit Location (QQQQ): <b>NE</b> <del>C</del> <del>S/2</del> <b>NW</b>
Type of Pit: <input type="checkbox"/> Emergency Pit <input type="checkbox"/> Burn Pit <input type="checkbox"/> Settling Pit <input checked="" type="checkbox"/> Drilling Pit <input type="checkbox"/> Workover Pit <input type="checkbox"/> Haul-Off Pit <small>(If WP Supply API No. or Year Drilled)</small>	Pit is: <input checked="" type="checkbox"/> Proposed <input type="checkbox"/> Existing If Existing, date constructed: _____ Pit capacity: <b>14,250</b> (bbls)	Sec. <b>12</b> Twp. <b>33</b> R. <b>2</b> <input type="checkbox"/> East <input checked="" type="checkbox"/> West <b>1650</b> Feet from <input checked="" type="checkbox"/> North / <input type="checkbox"/> South Line of Section <b>1650</b> Feet from <input type="checkbox"/> East / <input checked="" type="checkbox"/> West Line of Section <b>Sumner</b> County
Is the pit located in a Sensitive Ground Water Area? <input type="checkbox"/> Yes <input checked="" type="checkbox"/> No		Chloride concentration: _____ mg/l <small>(For Emergency Pits and Settling Pits only)</small>
Is the bottom below ground level? <input checked="" type="checkbox"/> Yes <input type="checkbox"/> No	Artificial Liner? <input type="checkbox"/> Yes <input checked="" type="checkbox"/> No	How is the pit lined if a plastic liner is not used?
Pit dimensions (all but working pits): <b>100</b> Length (feet) <b>100</b> Width (feet)    _____ N/A: Steel Pits Depth from ground level to deepest point: <b>8</b> (feet)		
If the pit is lined give a brief description of the liner material, thickness and installation procedure.		Describe procedures for periodic maintenance and determining liner integrity, including any special monitoring.
Distance to nearest water well within one-mile of pit <b>N/A</b> feet    Depth of water well _____ feet		Depth to shallowest fresh water <b>0</b> feet. Source of information: _____ measured    _____ well owner    _____ electric log    _____ KDWR
<b>Emergency, Settling and Burn Pits ONLY:</b> Producing Formation: _____ Number of producing wells on lease: _____ Barrels of fluid produced daily: _____ Does the slope from the tank battery allow all spilled fluids to flow into the pit? <input type="checkbox"/> Yes <input type="checkbox"/> No		<b>Drilling, Workover and Haul-Off Pits ONLY:</b> Type of material utilized in drilling/workover: <b>fresh water based mud</b> Number of working pits to be utilized: <b>3</b> Abandonment procedure: <b>evaporate and backfill</b> _____ Drill pits must be closed within 365 days of spud date.
I hereby certify that the above statements are true and correct to the best of my knowledge and belief.		
<b>5/22/07</b> Date		 Signature of Applicant or Agent
<b>KCC OFFICE USE ONLY</b>		
Date Received: <b>5/24/07</b> Permit Number: _____ Permit Date: <b>5/24/07</b> Lease Inspection: <input type="checkbox"/> Yes <input checked="" type="checkbox"/> No		

15-191-22502-0000