

CARD MUST BE TYPED

State of Kansas  
**NOTICE OF INTENTION TO DRILL**  
(see rules on reverse side)

CARD MUST BE SIGNED

Starting Date: December 4 1985  
month day year

API Number 15- 099-22,391-00-00

**OPERATOR:** License # 7166  
Name Oil Lift, Inc.  
Address 4450 Gen. DeGaulle Dr., Ste 1212  
City/State/Zip New Orleans, LA 70114  
Contact Person G. T. Alexander, Jr.  
Phone 504-392-2283

NE SE NE Sec 18 Twp 35 S, Rge 18  
(location)  East  West

330\* Ft North from Southeast Corner of Section  
330\* Ft West from Southeast Corner of Section  
(Note: Locate well on Section Plat on reverse side)

**CONTRACTOR:** License # 8827  
Name Treat-rite Water Labs, Inc.  
City/State Nowata, Oklahoma

Nearest lease or unit boundary line 330 feet.  
County Labette  
Lease Name Barndollar Well# 12

**Well Drilled For:** Well Class: Type Equipment:  
 Oil  Swd  Infield  Mud Rotary  
 Gas  Inj  Pool Ext.  Air Rotary  
 OWWO  Expl  Wildcat  Cable

Domestic well within 330 feet:  yes  no  
Municipal well within one mile:  yes  no  
\*Sec.18 is not full section due to State Line (see plat)

If OWWO: old well info as follows:  
Operator NA  
Well Name  
Comp Date Old Total Depth  
Projected Total Depth 410 feet  
Projected Formation at TD Oswego Limestone  
Expected Producing Formations Oswego Limestone

Depth to Bottom of fresh water feet  
Lowest usable water formation feet  
Depth to Bottom of usable water 100 feet  
Surface pipe by Alternate: 1  2   
Surface pipe to be set 20 feet \*\*  
Conductor pipe if any required feet  
Ground surface elevation feet MSL  
This Authorization Expires 6-2-86  
Approved By Reth 12-2-85

I certify that we will comply with K.S.A. 55-101, et seq., plus eventually plugging hole to K.C.C. specifications.


\*\*If productive, Prod. Casing will be cemented to surface.

Date 11/25/85 Signature of Operator or Agent P. S. [Signature] Title President

Must be filed with the K.C.C. five (5) days prior to commencing well  
 This card void if drilling not started within six (6) months of date received by K.C.C.

12-2-85

A Regular Section of Land  
 1 Mile = 5,280 Ft.

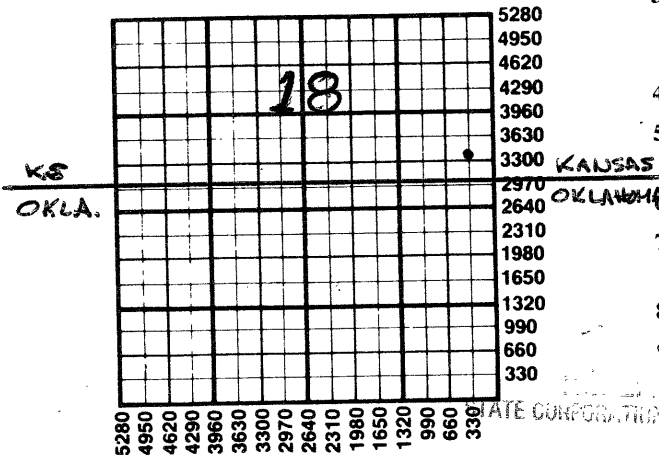

**Important procedures to follow :**

1. Notify District office before setting surface casing.
2. Set surface casing by circulating cement to the top.
3. File completion forms ACO-1 with K.C.C. within 90 days of well completion, following instructions on ACO-1, side 1, and including copies of wireline logs.
4. Notify District office 48 hours prior to old well workover or re-entry.
5. Prior to plugging, prepare a plugging plan, then obtain agreement from the appropriate district office for an approved plugging plan.
6. Submit plugging report (CP-4) to K.C.C. after plugging is completed.
7. Obtain an approved injection docket number before disposing of salt water.
8. Notify K.C.C. within 10 days when injection commences or terminates.
9. If an alternate 2 completion, cement in the production pipe from below any usable water to surface within 120 days of spud date.

STATE CORPORATION COMMISSION

State Corporation Commission of Kansas  
 Conservation Division  
 200 Colorado Derby Building  
 Wichita, Kansas 67202  
 (316) 263-3238

DEC 2 1985

CONSERVATION DIVISION  
 Wichita, Kansas