


STATE OF KANSAS
STATE CORPORATION COMMISSION

Give All Information Completely
Make Required Affidavit
Mail or Deliver Report to:
Conservation Division
State Corporation Commission
800 Bitting Building
Wichita, Kansas

WELL PLUGGING RECORD

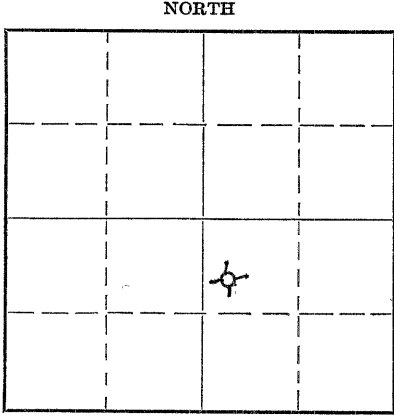

Locate well correctly on above
Section Plat

ROOKS County. Sec. 28-0 Twp. 90 Rge. 20 (W)
Location as "NE/CNW 1/4 SW 1/4" or footage from lines SW NW SE
Lease Owner C-G Drilling Co. Inc.
Lease Name Sutor "B" Well No. 2
Office Address 206 Union National Bank Bldg.
Character of Well (completed as Oil, Gas or Dry Hole) Dry Hole
Date well completed April 15, 1951 19
Application for plugging filed April 15, 1951
Application for plugging approved April 15, 1951
Plugging commenced April 15 1951
Plugging completed April 15 1951
Reason for abandonment of well or producing formation too low structurally
If a producing well is abandoned, date of last production 19
Was permission obtained from the Conservation Division or its agents before plugging was commenced? yes

Name of Conservation Agent who supervised plugging of this well Eldon Petty, Hays, Kans.
Producing formation Depth to top Bottom Total Depth of Well Feet
Show depth and thickness of all water, oil and gas formations.

OIL, GAS OR WATER RECORDS

CASING RECORD

Formation	Content	From	To	Size	Put In	Pulled Out
				8 5/8"	208.50' (28#)	

Describe in detail the manner in which the well was plugged, indicating where the mud fluid was placed and the method or methods used in introducing it into the hole. If cement or other plugs were used, state the character of same and depth placed, from feet to feet for each plug set.
Filled with drilling mud to 208'. Put in 15 sacks cement then pumped full of mud 25' from top of hole. Drove plug down to 25' then filled to top with 10 sacks of cement.

RECEIVED
STATE CORPORATION COMMISSION
APR 19 1951
4-19-51
DIVISION

(If additional description is necessary, use BACK of this sheet)
Correspondence regarding this well should be addressed to C-G Drilling Co. Inc., Kansas
Address 206 Union National Bank Bldg. Wichita, Kans.

STATE OF Kansas, COUNTY OF Sedgwick, ss.
R. A. Cook (owner or operator) of the above-described well,
being first duly sworn on oath, says: That I have knowledge of the facts, statements, and matters herein contained and the log of the above-described well as filed and that the same are true and correct. So help me God.
(Signature) R. A. Cook

206 Union National Bank Bldg.
(Address)

SUBSCRIBED AND SWORN TO before me this 17th day of April, 1951

Almeda [Signature]
Notary Public.

My commission expires August 11, 1954

PLUGGING
FILE SEC 28 T 9 R 20W
BOOK PAGE 74 LINE 40

CONTRACTOR'S WELL LOG

Operator C-G Drilling Co. Inc. Farm Name Sutor "B" #2
 Location SW NW SE Sec. 28-9-20W
 Pool Name Northampton County Rooks State Kans.
 Commencement Date 4-1-51 Completion Date 4-15-51

LOG OF WELL

Elevation 2287 R. B.
 All Measurements from the top of rotary bushing.

FROM	TO	FORMATION	DEVIATION FROM VERTICAL	REMARKS:
0	210			
210	400	Shale & Shells		
400	780	Shale-Sands		
780	920	Shale-Sands		
920	970	Sand		
970	1215	Shale-Sand		
1215	1270	Shale-Shells		
1270	1525	Sand		
1525	1700	Shale-Redbed	1500-0°	
1700	1787	Shale		
1787	1825	Anhydrite		
1825	1870	Shale-Shells		
1870	2035	Shale-Shells		
2035	2220	Shale	2000-0°	
2220	2380	Shale-Lime		
2380	2500	Lime-Shale		
2500	2630	Lime-Shale	2500-0°	
2630	2685	Lime-Shale		
2685	2840	Shale-Lime		
2840	2935	Lime-Shale		
2935	3000	Lime-Shale		
3000	3065	Lime-Shale	3000-0°	
3065	3140	Lime-Shale		
3140	3230	Lime-Shale		
3230	3355	Lime-Shale		
3355	3450	Lime-Shale		
3450	3505	Lime-Shale	3500-0°	
3505	3565	Lime-Shale		
3565	3630	Lime		
3630	3650	Lime		
3650	3705	Lime		
3705	3760	Lime-Shale		
3760	3825	Lime-Shale		
3825	3885	Lime-Shale		
3885	3887	T.D		

RECORDED
 APR 13 1951
 DIVISION

CASING LEFT IN HOLE AFTER COMPLETION

Ran 208.50' (7 Joints.) 8-5/8" Casing.

STATE OF KANSAS. COUNTY OF SEDGWICK) SS.

The undersigned certifies that to the best of his knowledge and belief, the above facts are true and correct.

C-G DRILLING CO. Inc.

By R. A. Cook
 President

Subscribed and sworn to before me this 17th day of April, 1951

PLUGGING
 FILE SEC 71 T 9 R 20W
74 40

My Commission expires:
 August 11, 1954

Almeda Lou
 Notary Public