

STATE OF KANSAS
STATE CORPORATION COMMISSION
Give All Information Completely
Make Required Affidavit
Mail or Deliver Report to:
Conservation Division
State Corporation Commission
800 Biting Building
Wichita, Kansas

WELL PLUGGING RECORD

Rooks

County. Sec. 28 Twp. 9 Rge. 20 (X) W (W)

Location as "NE/CNW $\frac{1}{4}$ SW $\frac{1}{4}$ " or footage from lines SE SE SW

Lease Owner Nadel and Gussman

Lease Name Kern Well No. 7

Office Address P. O. Box 309, Tulsa, Oklahoma

Character of Well (completed as Oil, Gas or Dry Hole) Dry

Date well completed 11-23-54

Application for plugging filed 11-23-54

Application for plugging approved 11-23-54


Plugging commenced 11-23-54

Plugging completed 11-23-54

Reason for abandonment of well or producing formation Dry

If a producing well is abandoned, date of last production _____ 19____

Was permission obtained from the Conservation Division or its agents before plugging was commenced? Yes

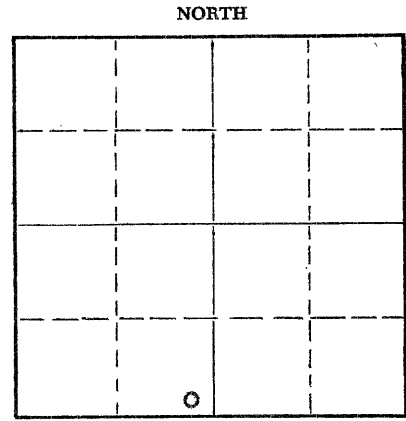

Locate well correctly on above Section Plat

Name of Conservation Agent who supervised plugging of this well Elden Petty

Producing formation _____ Depth to top _____ Bottom _____ Total Depth of Well 3900 Feet

Show depth and thickness of all water, oil and gas formations.

OIL, GAS OR WATER RECORDS

CASING RECORD

FORMATION	CONTENT	FROM	TO	SIZE	PUT IN	PULLED OUT
				8-5/8"	215'	0

Describe in detail the manner in which the well was plugged, indicating where the mud fluid was placed and the method or methods used in introducing it into the hole. If cement or other plugs were used, state the character of same and depth placed, from _____ feet to _____ feet for each plug set.

Filled hole to 190' of top, set plug and cemented with 1/2 sax hulls and 15 sax cement.

Filled hole to 40' of top, set plug and cemented with 1/2 sax hulls and 10 sax cement.

12-2-54

(If additional description is necessary, use BACK of this sheet)

Name of Plugging Contractor Reserve Drilling Company, Inc.
Address 703 Union National Bank Bldg. Wichita 2, Kansas

STATE OF KANSAS, COUNTY OF SEDGWICK, ss.
George A. Reed (employee of owner) of the above-described well, being first duly sworn on oath, says: That I have knowledge of the facts, statements, and matters herein contained and the log of the above-described well as filed and that the same are true and correct. So help me God.

(Signature) George A. Reed

(Address) _____

SUBSCRIBED AND SWORN TO before me this 26th day of November, 1954

My commission expires Nov. 3, 1956

Paul Bass
Notary Public.

PLUGGING
FILED SEC 28 T 9 R 20W
BOOK PAGE 80 LINE 13

NADEL AND GUSMAN

KERN No. 7

SE SE SW 28-9-20W
Rooks County, Kansas

Comm: 11-14-54

Comp: 11-22-54

Casing: 8-5/8" 215' w/125 saz

Formations

Depth

Sand	100
Shale and shells	213
Sand, shale and shells	1455
Shale and red bed	1773
Anhydrite	1815
Shale and shells	2215
Line and shale	2410
Line	2505
Line and shale	3315
Sandy lime and shale	3411
Shale and lime	3482
Line	3730
Line and shale	3767
Conglomerate and shale	3820
Conglomerate	3900

Geological Tops

Neehner	3538
Toronto	3560
Lansing-Kansas C.	3578
Conglomerate	3847

STATE OF KANSAS

COUNTY OF SEDGWICK

} SS:

PLUGGING		
FILE	SEC 28	T 9 R 20W
BOOK	PAGE 80	LINE 13

George A. Reed, of lawful age, deposes and states that the above formations and depths are correct as shown by the daily drilling log of the Kern No. 7 Well in the SE SE SW 28-9-20W, Rooks County, Kansas.

George A. Reed

Subscribed and sworn to before me this 26th day of November, 1954.

Walter B. Babb
Notary Public

My commission expires Nov. 3, 1956