


STATE OF KANSAS  
STATE CORPORATION COMMISSION

WELL PLUGGING RECORD

Give All Information Completely  
Make Required Affidavit  
Mail or Deliver Report to  
Conservation Division  
State Corporation Comm.  
245 North Water  
Wichita, KS 67202

Rooks County, Sec. 33 Twp. 9 Rge. 20 E/W  
Location as "NE/CNW $\frac{1}{4}$ SW $\frac{1}{4}$ " or footage from lines  
C W/2 SW SW

Lease Owner Trumart Oil Co.  
Lease Name Hinkhouse Well No. 1  
Office Address Box 12, Ellis, Kansas 67637  
Character of Well (Completed as Oil, Gas or Dry Hole)           
         Dry Hole

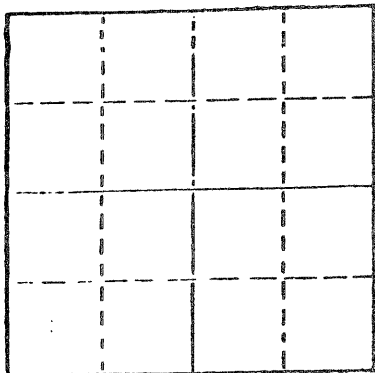

Locate well correctly on above  
Section Plat

Date Well completed October 27 1976  
Application for plugging filed October 27 1976  
Application for plugging approved October 27 1976  
Plugging commenced October 27 1976  
Plugging completed October 27 1976

Reason for abandonment of well or producing formation  
         dry hole

If a producing well is abandoned, date of last production  
         19        

Was permission obtained from the Conservation Division or  
its agents before plugging was commenced?          yes

Name of Conservation Agent who supervised plugging of this well Gilbert Balthazor  
Producing formation          Depth to top          Bottom          Total Depth of Well 3835  
Show depth and thickness of all water, oil and gas formations.

OIL, GAS OR WATER RECORDS

CASING RECORD

FORMATION	CONTENT	FROM	TO	SIZE	PUT IN	PULLED OUT

Describe in detail the manner in which the well was plugged, indicating where the mud fluid  
was placed and the method or methods used in introducing it into the hold. If cement or other  
plugs were used, state the character of same and depth placed, from          feet to  
         feet for each plug set.

Hole full of heavy mud to 850' w/70 sacks 50/50 Pozmix, 6% Gel thru drill pipe.  
Mud to 300' w/20 sacks 50/50 Pozmix, 6% Gel thru drill pipe.  
Mud to 40' w/ $\frac{1}{2}$  sack hulls plug and 10 sacks cement.

RECEIVED  
STATE CORPORATION COMMISSION  
10/29/76  
OCT 29 1976  
CONSERVATION DIVISION  
Wichita, Kansas

(If additional description is necessary, use BACK of this sheet)

Name of Plugging Contractor          Duke Drilling Co.

STATE OF          KANSAS COUNTY OF          BARTON, ss.  
         Larry Curtis (employee of owner) or (~~owner or operator~~)  
of the above-described well, being first duly sworn on oath, says: That I have knowledge of  
the facts, statements, and matters herein contained and the log of the above-described well  
as filed and that the same are true and correct. So help me God.

(Signature)          Larry Curtis  
         Box 823, Great Bend, Kansas 67530  
         (Address)

SUBSCRIBED AND SWORN TO before me this          28th          day of          October         , 19          76

My commission expires          April 11, 1978

                  Notary Public.

DRILLERS' WELL LOG

DATE COMMENCED: October 20, 1976  
DATE COMPLETED: October 27, 1976

Trumart Oil Co.  
WINDHOUSE # 1  
C W/2 SW SW  
Sec 33-T9-R20  
Rooks County, Kansas

ELEVATION: 2263 K.B.

0	-	905'	Shale and Clay
905	-	1490'	Shale and Sand Streaks
1490	-	1755'	Red Bed
1755	-	1796'	Anhydrite
1796	-	3291'	Shale and Lime
3291	-	3494'	Lime
3494	-	3498'	Shale
3498	-	3753'	Lime
3753	-	3832'	Lime and Shale
3832	-	3835'	Dolomite
		3835'	RID

FORMATION TOPS

Anhydrite	1755
Topeka	3291
Heebner	3494
Toronto	3517
Lansing	3538
Base K.O.	3753
Artuckle	3832
RID	3835

SURFACE PIPE:  
Set used 8 5/8", 28# pipe at  
382' w/200 sacks Common, 2% Gel,  
3% cc.

AFFIDAVIT

STATE OF KANSAS }  
COUNTY OF BARTON } ss.

Larry Curtis, of lawful age, does swear and state that the facts and statements herein contained are true and correct to the best of his knowledge.

Larry Curtis

Subscribed and sworn to before me this 28th day of October, 1976.

Maechy M. Hague  
Notary Public

My Commission Expires: April 11, 1978