


WELL PLUGGING RECORD

Give All Information Completely  
Make Required Affidavit  
Mail or Deliver Report to:  
Conservation Division  
State Corporation Commission  
212 No. Market  
Wichita, Kansas

ROOKS County. Sec. 33 Twp. 9S Rge. 20 (R) (W)

Location as "NE/CNW/SW" or footage from lines SW SE SW  
Lease Owner PETROLEUM, INC.,  
Lease Name MARCOTTE "B" Well No. 1  
Office Address R.R. #2, GREAT BEND, KANSAS  
Character of Well (completed as Oil, Gas or Dry Hole) DRY HOLE  
Date well completed MAY 9 19 66  
Application for plugging filed MAY 9 19 66  
Application for plugging approved MAY 9 19 66  
Plugging commenced MAY 9 19 66  
Plugging completed MAY 9 19 66  
Reason for abandonment of well or producing formation NO PRODUCIBLE FORMATION

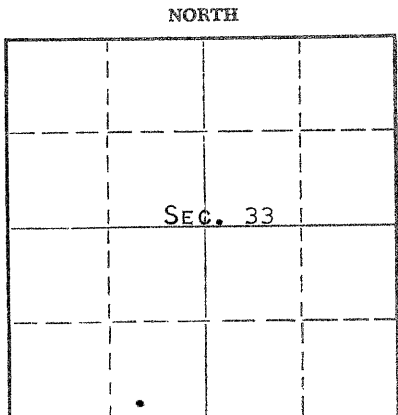

Locate well correctly on above Section Plat

If a producing well is abandoned, date of last production NONE 19  
Was permission obtained from the Conservation Division or its agents before plugging was commenced? YES

Name of Conservation Agent who supervised plugging of this well LEO F. MASSEY  
Producing formation \_\_\_\_\_ Depth to top \_\_\_\_\_ Bottom \_\_\_\_\_ Total Depth of Well 3835 Feet  
Show depth and thickness of all water, oil and gas formations.

OIL, GAS OR WATER RECORDS

CASING RECORD

FORMATION	CONTENT	FROM	TO	SIZE	PUT IN	PULLED OUT
				8-5/8"	390'	NONE

Describe in detail the manner in which the well was plugged, indicating where the mud fluid was placed and the method or methods used in introducing it into the hole. If cement or other plugs were used, state the character of same and depth placed, from \_\_\_\_\_ feet to \_\_\_\_\_ feet for each plug set.

MUDDED UP WITH HEAVY MUD TO 550', FOLLOWED BY WOODEN PLUG, PLACED 20 SACKS CEMENT ON TOP OF PLUG. MUDDED UP WITH HEAVY MUD TO 390', FOLLOWED BY WOODEN PLUG, PLACED 20 SACKS CEMENT ON TOP OF PLUG. MUDDED UP WITH HEAVY MUD TO 40' FOLLOWED BY WOODEN PLUG, PLACED 10 SACKS CEMENT ON TOP OF PLUG TO BASE OF WELL CELLAR.

RECEIVED  
STATE CORPORATION COMMISSION  
5/25/66  
MAY 25 1966

(If additional description is necessary, use BACK of this sheet)  
Name of Plugging Contractor GARVEY DRILLING COMPANY  
Address R.R. #2, GREAT BEND, KANSAS

STATE OF KANSAS, COUNTY OF BARTON, ss.  
MONTE CHADD (employee of owner) or (owner or operator) of the above-described well, being first duly sworn on oath, says: That I have knowledge of the facts, statements, and matters herein contained and the log of the above-described well as filed and that the same are true and correct. So help me God. MONTE CHADD, DIST. PROD. SUPT.

(Signature) *Monte Chadd*  
R.R. #2, Great Bend, Ks.  
(Address)

SUBSCRIBED AND SWORN TO before me this 10 day of MAY, 19 66

My commission expires MAY 28, 1969

*Richard H. Dumber*  
Notary Public.

# WELL LOG

COMPANY Petroleum, Inc.

SEC. 33 T-9S R-20W

FARM Marcotte

NO. B-1

LOC. SW SE SW


TOTAL DEPTH 3835'

COUNTY Rooks

COMM. 5-2-66

COMP. 5-9-66

CONTRACTOR Garvey Drilling Company

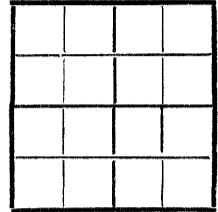

CASING 8 5/8" @ 390' w/250 sx

ELEVATION 2242' KB

PRODUCTION D & A

FIGURES INDICATE BOTTOM OF FORMATIONS

- 45' Post Rock
- 160' Shale and Shells
- 390' Blue Shale
- 890' Shale
- 1004' Sand
- 1435' Shale and Shells
- 1735' Shale, Shells, and Sand Streaks
- 1738' Shale and Sand
- 1772' Anhydrite
- 2135' Shale and Shells
- 2435' Shale and Lime Streaks
- 3477' Lime and Shale
- 3824' Lime
- 3835' Lime and Arbuckle
- 3835' RTD

**RECEIVED**  
STATE CORPORATION COMMISSION  
MAY 25 1966  
CONSERVATION DIVISION  
Topeka, Kansas

State of Kansas }  
County of Barton } SS

I, Sam N. Stephens of Garvey Drilling Company

upon oath state the above and foregoing is a true and correct copy of the log of the Marcotte B-1 well.

Sam N. Stephens

Subscribed and sworn to before me this 23rd day of May 1966

My Commission Expires: November 5th, 1969

Richard Boyd  
NOTARY PUBLIC