


STATE OF KANSAS
STATE CORPORATION COMMISSION

Give All Information Completely
Make Required Affidavit
Mail or Deliver Report to:
Conservation Division
State Corporation Commission
800 Bitting Building
Wichita, Kansas

WELL PLUGGING RECORD

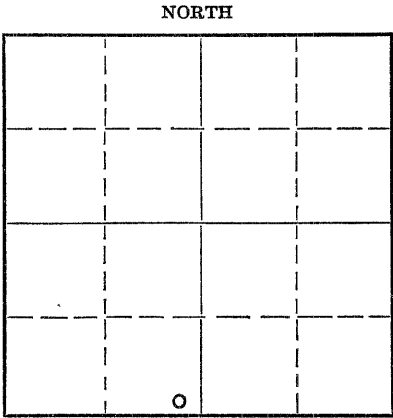

Locate well correctly on above
Section Plat

Rooks County. Sec. 33 Twp. 9S Rge. 20W (E) (W)
Location as "NE/CNW $\frac{1}{4}$ SW $\frac{1}{4}$ " or footage from lines SE SE SW
Lease Owner Lohmann-Johnson Drilling Co., Inc.
Lease Name Marcotte "A" Well No. 3
Office Address Evinsville, Indiana
Character of Well (completed as Oil, Gas or Dry Hole) Oil
Date well completed _____ 19____
Application for plugging filed September 14, 1951 (verbal) 19____
Application for plugging approved September 20, 1951 19____
Plugging commenced 9-14-51 19____
Plugging completed 9-16-51 19____
Reason for abandonment of well or producing formation oil depleted

If a producing well is abandoned, date of last production _____ 19____
Was permission obtained from the Conservation Division or its agents before plugging was commenced? Yes

Name of Conservation Agent who supervised plugging of this well Petty
Producing formation _____ Depth to top _____ Bottom _____ Total Depth of Well 3850 Feet
Show depth and thickness of all water, oil and gas formations.

OIL, GAS OR WATER RECORDS

CASING RECORD

Formation	Content	From	To	Size	Put In	Pulled Out
				8-5/8"	340'	None
				5-1/2"	3848'	3205'

Describe in detail the manner in which the well was plugged, indicating where the mud fluid was placed and the method or methods used in introducing it into the hole. If cement or other plugs were used, state the character of same and depth placed, from _____ feet to _____ feet for each plug set.

Hole bridged with mud at 1100'. Drilled out to 3625' and pushed plug to 3530'. Ran 4 sacks of cement. Mudded hole to 270'. set rock bridge to 250' and ran 15 sacks of cement. Mudded hole to 30' and ran 10 sacks of cement. Plugging completed.

Received
11/2/51

(If additional description is necessary, use BACK of this sheet)
Name of Plugging Contractor West Supply Company
Address Chase, Kansas

STATE OF Indiana, COUNTY OF Vanderburgh, ss.
James W. Kendall (employee of owner) or (owner or operator) of the above-described well, being first duly sworn on oath, says: That I have knowledge of the facts, statements, and matters herein contained and the log of the above-described well as filed and that the same are true and correct. So help me God.

(Signature) J. W. Kendall
(Address) _____

SUBSCRIBED AND SWORN to before me this 10-10-51 day of _____, 19____

My commission expires July 30th 1954
Walter Singleton Notary Public.

23-8390-3 6-51-20M
PLUGGING
FILE SEC 33 T 9 R 200
BOOK PAGE 110 LINE 31

W E L L L O G

Described as Marcotte 3"A"
located in Hooks Co., Kansas

FROM	TO	FORMATION
0	40	Surface Soil & Sand
40	350	Shale & sand
350	842	Sand & shale
842	1230	Shale, sand, & shells
1230	1744	Shale & shells
1744	1753	Anhydrite
1753	1790	Anhydrite
1790	1894	Shale & lime
1894	2120	Shale & lime
2120	2260	Lime & shale
2260	3849	Lime & Shale
3849		Total Depth

I, the undersigned, being first duly sworn upon oath, state that this well record is true, correct and complete according to the records of this office and to the best of my knowledge and belief.

D. Given

D. Given

Subscribed and sworn to before me this 31st day of October, 1951.

My Commission Expires:
October 14, 1953

Art M. Trump

Notary Public

RECEIVED
STATE CORPORATION COMMISSION

NOV - 2 1951

COMPLETION DIVISION
Wichita, Kansas

PLUGGING
SEC 35 T 9 R 20W
PAGE 100 LINE 31