


15-163-02677-00-00

STATE OF KANSAS  
STATE CORPORATION COMMISSION

WELL PLUGGING RECORD

Give All Information Completely  
Make Required Affidavit  
Mail or Deliver Report to:  
Conservation Division  
State Corporation Commission  
800 Bitting Building  
Wichita, Kansas

Rocks \_\_\_\_\_ County. Sec. 33 Twp. 9s Rge. 20 (E) \_\_\_\_\_ (W) \_\_\_\_\_  
Location as "NE/CNW $\frac{1}{4}$ SW $\frac{1}{4}$ " or footage from lines Center NE NW NW  
Lease Owner Hesla Oil Co., I. O. Miller, S. A. Murphy  
Lease Name Set Bruggemann Well No. 2  
Office Address 701 Brown Bldg., Wichita, Kansas  
Character of Well (completed as Oil, Gas or Dry Hole) dry hole  
Date well completed October 25, 1951 19 \_\_\_\_\_  
Application for plugging filed October 25 19 51  
Application for plugging approved October 25 19 51  
Plugging commenced October 25 19 51  
Plugging completed October 25 19 51  
Reason for abandonment of well or producing formation dry hole  
If a producing well is abandoned, date of last production \_\_\_\_\_ 19 \_\_\_\_\_  
Was permission obtained from the Conservation Division or its agents before plugging was commenced? yes

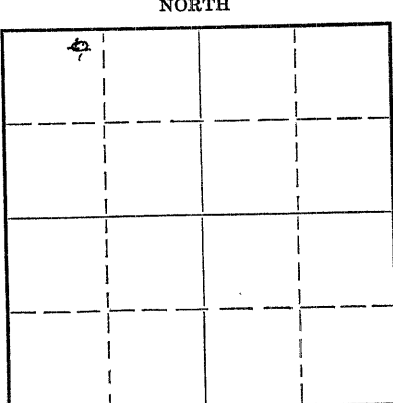

Locate well correctly on above  
Section Plat

Name of Conservation Agent who supervised plugging of this well Eldon Petty Box 326, Hays, Kansas  
Producing formation \_\_\_\_\_ Depth to top \_\_\_\_\_ Bottom \_\_\_\_\_ Total Depth of Well 3914 Feet  
Show depth and thickness of all water, oil and gas formations.

OIL, GAS OR WATER RECORDS

CASING RECORD

Formation	Content	From	To	Size	Put In	Pulled Out
				<u>8-5/8</u>	<u>160</u>	<u>none</u>

Describe in detail the manner in which the well was plugged, indicating where the mud fluid was placed and the method or methods used in introducing it into the hole. If cement or other plugs were used, state the character of same and depth placed, from \_\_\_\_\_ feet to \_\_\_\_\_ feet for each plug set.

Mudded to 152 feet.  
Set bottom plug @ 152 feet with 15 sacks cement.  
Mudded to 40 feet.  
Set Plug @ 40 feet with 10 sacks cement.

(If additional description is necessary, use BACK of this sheet)  
Name of Plugging Contractor Virginia Drilling Co., Inc.  
Address 701 Brown Bldg.  
Wichita 2, Kansas

STATE OF Kansas, COUNTY OF Sedgwick, ss.  
S. A. Murphy (employee of owner) or (owner or operator) of the above-described well,  
being first duly sworn on oath, says: That I have knowledge of the facts, statements, and matters herein contained and the log of the above-described well as filed and that the same are true and correct. So help me God.

(Signature) S. A. Murphy  
701 Brown Building, Wichita 2, Kansas  
(Address)

SUBSCRIBED AND SWORN to before me this 30th day of October, 1951  
Ivey M. Newman  
Notary Public.

My commission expires March 15, 1954  
28-8390-s 6-51-20M

PLUGGING  
SEE 33 T 9 ROW  
PAGE 110 LINE 8

11/1/51  
351  
NOTARY

Well: Bruggeman #2  
 Location: Center NE NW NW, Section 33-9s-20w, Rocks Co., Kansas  
 Company: Hesla Oil Co., S. A. Murphy, I. O. Miller  
 Contractor: Virginia Drilling Co., Inc.  
 Commenced: October 11, 1951  
 Completed: October 25, 1951  
 Total Depth: 3914  
 Elevation: 2290 KB 2285 Gr 2287 DF

FORMATION	DEPTH	
Clay-shells	0-163	
Shale-shells	160-630	
Sand	630-695	
Shale-shells	695-770	Set 8-5/8" csg. @ 160'
Sand	770-1180	
Shale-shells	1180-1250	
Sand, shale, shells	1250-1515	
Sand	1515-1525	
Red Sand	1525-1530	
Shale-shells	1530-1791	TOPS:
Anhydrite	1791-1844	Anhydrite 1791
Shale-shells	1844-2300	Topeka 3341
Shale-lime	2300-3207	Heebner 3553
Lime-broken	3207-3275	Lansing 3591
Lime-shale, brk. lime	3275-3345	Kansas City 3817
Lime-shale	3345-3418	Shale Conglomerate 3864
Lime	3418-3495	Chert Conglomerate 3901
Lime-shale	3495-3553	
Shale	3553-3576	
Shale-lime	3576-3620	
Lime	3620-3715	
Shale-lime	3715-3741	
Lime	3741-3845	
Lime-shale-cong.	3845-3880	
Shale-conglomerate	3880-3901	
Chert-conglomerate	3901-3914	

Now comes S. A. Murphy, who states that he is familiar with the drilling of oil and gas wells and knows of his own knowledge that the Bruggeman #2 located in the Center of the NE NW NW Section 33-9s-20w, Rocks County, Kansas, was drilled to a total depth of 3914 feet. Same was plugged and abandoned.

Subscribed and sworn to before me this 30th day of October, 1951.

My commission expires March 15, 1954.

*S. A. Murphy*  
 \_\_\_\_\_  
*Irving M. Newman*  
 \_\_\_\_\_  
 Notary Public

