

STATE OF KANSAS
STATE CORPORATION COMMISSION

WELL PLUGGING RECORD


OR
FORMATION PLUGGING RECORD

Strike out upper line
when reporting plug-
ging off formations.

Give All Information Completely
Make Required Affidavit
Mail or Deliver Report to:
Conservation Division
State Corporation Commission
800 Biting Building
Wichita, Kansas

Rocks..... County. Sec. 33 Twp. 9S Rge. (E) 20 (W)
Location as "NE1/4NW1/4SW1/4" or footage from lines. SE/cor. NW/4
Lease Owner. Virginia Drilling Company, Inc. & I. O. Miller
Lease Name. Bruaggamen Well No. 1
Office Address. 701 Brown Bldg., Wichita 2, Kansas
Character of Well (completed as Oil, Gas or Dry Hole) Dry Hole
Date well completed. April 29 19 48
Application for plugging filed. April 29 19 48
Application for plugging approved. April 29 19 48
Plugging commenced. April 29 19 48
Plugging completed. April 29 19 48
Reason for abandonment of well or producing formation. Dry Hole
If a producing well is abandoned, date of last production. 19
Was permission obtained from the Conservation Division or its agents before plugging was com-
menced? yes

NORTH

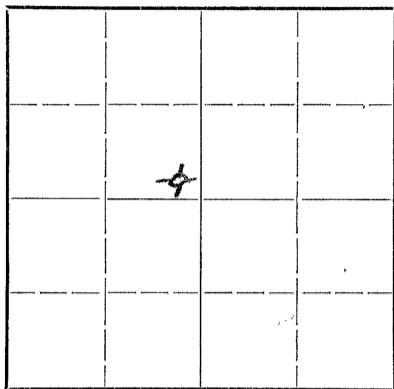

Locate well correctly on above
Section Plat

Name of Conservation Agent who supervised plugging of this well. M. A. Rives
Producing formation. Depth to top. Bottom. Total Depth of Well. 3936 Feet
Show depth and thickness of all water, oil and gas formations.

OIL, GAS OR WATER RECORDS

CASING RECORD

Formation	Content	From	To	Size	Put In	Pulled Out
				8-5/8"	133	None

Describe in detail the manner in which the well was plugged, indicating where the mud fluid was placed and the method or methods used in introducing it into the hold. If cement or other plugs were used, state the character of same and depth placed, from.....feet to.....feet for each plug set.

Filled w/ heavy mud from bottom (3936) to 133'. Set Halliburton plug, mixed 15 sacks cement on top of plug. Filled w/ heavy mud to 25' of surface, then set Halliburton plug and filled to surface w/ cement.

(If additional description is necessary, use BACK of this sheet)

5/18/48
MAY 8 - 1948

Correspondence regarding this well should be addressed to. Virginia Drilling Company, Inc.
Address. 701 Brown Building, Wichita 2, Kansas

STATE OF Kansas, COUNTY OF Sedgwick, ss.
Murlee Hawkins (employee of owner) or (owner or operator) of the above-described well,
being first duly sworn on oath, says: That I have knowledge of the facts, statements, and matters herein contained and the log of the above-described well as filed and that the same are true and correct. So help me God.


(Signature) *Murlee Hawkins*

701 Brown Bldg., Wichita 2, Kansas
(Address)

SUBSCRIBED AND SWORN to before me this 6th day of May, 1948

Effie J. Looe
Notary Public.

My commission expires April 23, 1949

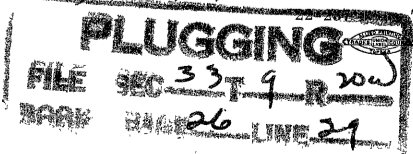

Well: Brueggeman #1
 Location: SE/cor. NW/4 Section 33-9S-20W, Rooks County, Kansas
 Company: Virginia Drilling Company, Inc. & I. O. Miller
 Contractor: Virginia Drilling Company, Inc.
 Commenced: April 15, 1948
 Completed: April 29, 1948
 Elevation: 2281
 Total Depth: 3936
 FORMATION

FORMATION	DEPTH
Surface clay	0-20
Sand	20-60
Shald-shells	60-135
Shale	135-523
Shale-shells	523-950
Sand	950-1125
Sand, shale, shells	1125-1500
Shale-shells	1500-1640
Anhydrite	1640-1680
Shale-shells	1680-1865
Shale-shells-salt	1865-2030
Shale-shells	2030-2315
Shale-lime	2315-2395
Sand-lime-shale	2395-2440
Shale-lime	2520-2555
Lime-shale	2555-2730
Shale	2730-2820
Shale-shells	2820-2925
Shale-lime	2925-3286
Lime	3286-3294
Lime-shale	3294-3354
Lime-shells-shale	3354-3436
Lime-pyrite	3436-3490
Lime	3490-3563
Lime-chert	3563-3599
Lime	3599-3687
Lime-chert	3687-3750
Lime	3750-3839
Conglomerate-chert	3839-3874
Conglomerate	3874-3936

CIRCULATE:

1 1/2 hrs @ 3506
 1 hr @ 3687
 1 hr @ 3813

TOPS:

Topeka	3542
Heebner shale	3552
Dodge	3572
Lansing-KC	3592
Marmaton	3828
Soeey Conglomerate	3838

Set 133' of 8-5/8" csg.

Now comes Murlee Hawkins, who states that she is familiar with the drilling of oil and gas wells and knows of her own knowledge that the Brueggeman #1, located in the SE/corner of the NW/4 Section 33-9S-20W, Rooks County, Kansas, was drilled to a total depth of 3936 feet, same was plugged and abandoned.

Murlee Hawkins

Subscribed and sworn to before me, a Notary Public, this 6th day of May 1948.

Effie J. Foor
 Notary Public

My commission expires:
 April 23, 1949.

