


STATE OF KANSAS
STATE CORPORATION COMMISSION

WELL PLUGGING RECORD

Give All Information Completely
Make Required Affidavit
Mail or Deliver Report to:
Conservation Division
State Corporation Commission
800 Biting Building
Wichita, Kansas

NORTH

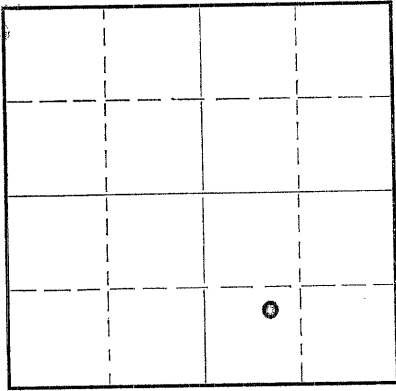

Locate well correctly on above
Section Plat

Rooks County. Sec. **33** Twp. **9S** Rge. **20W (E)**.....(W)
Location as "NE/CNW $\frac{1}{4}$ SW $\frac{1}{4}$ " or footage from lines **NE SW SE**
Lease Owner **Lohmann-Johnson Drilling Co., Inc.**
Lease Name **Marcotte** Well No. **2-B**
Office Address **320 Indiana Bank Bldg., Evansville, Indiana**
Character of Well (completed as Oil, Gas or Dry Hole) **Dry Hole**
Date well completed **May 28, 1949** 19.....
Application for plugging filed **(verbal) May 28, 1949** 19.....
Application for plugging approved **June 3, 1949** 19.....
Plugging commenced **May 29, 1949** 19.....
Plugging completed **May 29, 1949** 19.....
Reason for abandonment of well or producing formation **Dry Hole**

If a producing well is abandoned, date of last production..... 19.....
Was permission obtained from the Conservation Division or its agents before plugging was commenced? **Yes**

Name of Conservation Agent who supervised plugging of this well **C. D. Stough**
Producing formation..... Depth to top **3870** Bottom **3873** Total Depth of Well **3873** Feet
Show depth and thickness of all water, oil and gas formations.

OIL, GAS OR WATER RECORDS

CASING RECORD

Formation	Content	From	To	Size	Put In	Pulled Out
				8 5/8"	317'	0

Describe in detail the manner in which the well was plugged, indicating where the mud fluid was placed and the method or methods used in introducing it into the hole. If cement or other plugs were used, state the character of same and depth placed, from..... feet to..... feet for each plug set.

**317 feet of 8 5/8" circulated with cement.
Filled with heavy rotary mud from 3873
feet to 317 feet. Set wood plug and 15
sacks of cement. Filled with mud to
30 feet and set wood plug, rock and 10
sacks of cement.**

RECEIVED

7/7/49
JUL - 7 1949

STATE CORPORATION
COMMISSION
KANSAS

(If additional description is necessary, use BACK of this sheet)

Correspondence regarding this well should be addressed to **Lohmann-Johnson Drilling Co., Inc.**
Address **320 Indiana Bank Bldg.,
Evansville, Indiana**

STATE OF....., COUNTY OF....., ss.

..... (employee of owner) or (owner or operator) of the above-described well,
being first duly sworn on oath, says: That I have knowledge of the facts, statements, and matters herein contained and the log of the above-described well as filed and that the same are true and correct. So help me God


(Signature) *[Signature]*

(Address)

SUBSCRIBED AND SWORN to before me this **5th** day of **July**, 19**49**

My commission expires **Oct. 14 - 1949**

[Signature]
Notary Public.

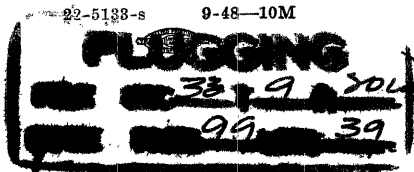

WELL LOG

Marcotte "E" 2 located in
Section 33, Township 9 South,
Range 20 West, Rooks County,
Kansas.

<u>FORMATION</u>	<u>FROM</u>	<u>TO</u>
Surface soil & sand	0	20
Sand & Shale	20	330
Shale & Shells	330	1010
Shale, sand & shells	1010	1556
Shale & Shells	1556	1755
Anhydrite	1755	1798
Broken Lime & Shale	1798	1948
Shale & Lime	1948	2365
Lime	2365	2705
Lime & Shale	2705	3305
Lime	3305	3310
Lime & Shale	3310	3382
Lime	3382	3457
Shale	3457	3496
Lime & Shale	3496	3559
Lime & chert	3559	3583
Lime & Shale	3583	3665
Lime	3665	3743
Lime & Shale	3743	3821
Cherty Conglomerate	3821	3840
Chert	3840	3847
Congl.	3847	3854
Congl.	3854	3870
Lime	3870	3873
Total Depth	3873	

RECEIVED

Conservation Div.

JUN 29 1949

STATE CORPORATION
COMMISSION
KANSAS

PLUGGING

FILE NO. 33-9-20w
PAGE 99 LINE 39