


STATE OF KANSAS
STATE CORPORATION COMMISSION

WELL PLUGGING RECORD

Give All Information Completely
Make Required Affidavit
Mail or Deliver Report to:
Conservation Division
State Corporation Commission
800 Bitting Building
Wichita, Kansas

Rooks County. Sec. 36 Twp. 9 Rge. 20XXXXXX (W)
Location as "NE/CNW/SW" or footage from lines C S/2 NW SW
Lease Owner Francis Oil and Gas
Lease Name Gish Well No. #4
Office Address 902 Palace Bldg., Tulsa, Oklahoma
Character of Well (completed as Oil, Gas or Dry Hole) dry hole
Date well completed February 8, 1955
Application for plugging filed February 8, 1955
Application for plugging approved February 8, 1955
Plugging commenced February 9, 1955
Plugging completed February 9, 1955
Reason for abandonment of well or producing formation
Commercial quantity of oil not found
If a producing well is abandoned, date of last production 19
Was permission obtained from the Conservation Division or its agents before plugging was commenced? yes

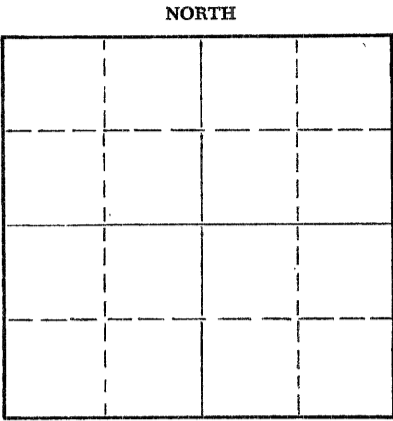

Locate well correctly on above Section Plat

Name of Conservation Agent who supervised plugging of this well Eldon Petty
Producing formation _____ Depth to top _____ Bottom _____ Total Depth of Well 3861 Feet
Show depth and thickness of all water, oil and gas formations.

OIL, GAS OR WATER RECORDS

CASING RECORD

FORMATION	CONTENT	FROM	TO	SIZE	PUT IN	PULLED OUT
				8 5/8	213'	none

Describe in detail the manner in which the well was plugged, indicating where the mud fluid was placed and the method or methods used in introducing it into the hole. If cement or other plugs were used, state the character of same and depth placed, from _____ feet to _____ feet for each plug set.

Filled hole with heavy mud from 3861 to 200'. Set wooden plug with 15 sacks cement. Second plug at 40' with 10 sacks cement.

2/12/55

(If additional description is necessary, use BACK of this sheet)

Name of Plugging Contractor K & E DRILLING, INC.
Address 1006 Central Avenue, Wichita, Kansas

STATE OF KANSAS, COUNTY OF SEDGWICK, ss.
Dale Silcott (employee or owner) or (owner or operator) of the above-described well, being first duly sworn on oath, says: That I have knowledge of the facts, statements, and matters herein contained and the log of the above-described well as filed and that the same are true and correct. So help me God.

(Signature) Dale Silcott
1006 Central Bldg., Wichita, Kansas
(Address)

SUBSCRIBED AND SWORN TO before me this 11th day of February, 1955

My commission expires June 25, 1956
Francis Masler Notary Public.

