


Give All Information Completely  
Make Required Affidavit  
Mail or Deliver Report to:  
Conservation Division  
State Corporation Commission  
212 No. Market  
Wichita, Kansas

WELL PLUGGING RECORD

NORTH

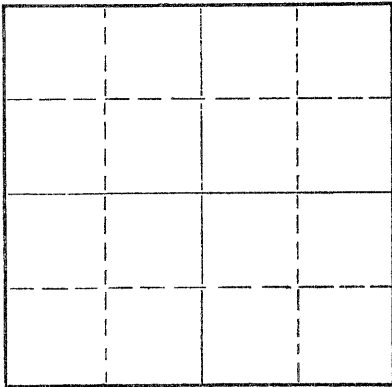

Locate well correctly on above  
Section Plat

Rooks County. Sec. 36 Twp. 9S Rge. 20 (E) W (W)  
Location as "NE/CNW/SW" or footage from lines NW SE SE  
Lease Owner White & Ellis Drilling Company  
Lease Name Pywell Well No. 2  
Office Address P.O. Box 448 Eldorado, Kansas  
Character of Well (completed as Oil, Gas or Dry Hole) D & A  
Date well completed December 22, 19 67  
Application for plugging filed December 22, 19 67  
Application for plugging approved December 22, 19 67  
Plugging commenced December 22, 19 67  
Plugging completed December 22, 19 67  
Reason for abandonment of well or producing formation D & A

If a producing well is abandoned, date of last production \_\_\_\_\_ 19\_\_\_\_  
Was permission obtained from the Conservation Division or its agents before plugging was commenced? Yes

Name of Conservation Agent who supervised plugging of this well Gilbert Leiker  
Producing formation \_\_\_\_\_ Depth to top \_\_\_\_\_ Bottom \_\_\_\_\_ Total Depth of Well 3819 Feet  
Show depth and thickness of all water, oil and gas formations.

OIL, GAS OR WATER RECORDS

CASING RECORD

FORMATION	CONTENT	FROM	TO	SIZE	PUT IN	PULLED OUT
				8 5/8"	227.09'	-0-

Describe in detail the manner in which the well was plugged, indicating where the mud fluid was placed and the method or methods used in introducing it into the hole. If cement or other plugs were used, state the character of same and depth placed, from \_\_\_\_\_ feet to \_\_\_\_\_ feet for each plug set.

Plug @ 800 w/100 sx cem  
Plug @ 210' w/25 sx cem  
Plug @ 40' w/10 sx cem

RECEIVED  
STATE CORPORATION COMMISSION  
2/29/68  
FEB 29 1968  
CONSERVATION DIVISION  
Wichita, Kansas

(If additional description is necessary, use BACK of this sheet)

Name of Plugging Contractor Red Tiger Drilling Company  
Address 1720 Wichita Plaza Wichita, Kansas

STATE OF KANSAS, COUNTY OF SEDGWICK, ss.  
Norman E. Klein (employee of owner) or (owner or operator) of the above-described well, being first duly sworn on oath, says: That I have knowledge of the facts, statements, and matters herein contained and the log of the above-described well as filed and that the same are true and correct. So help me God.

(Signature) Norman E Klein  
1720 Wichita Plaza, Wichita, Ks.  
(Address)

SUBSCRIBED AND SWORN TO before me this 26th day of December, 19 67

My commission expires 3-22-71  
Betty M Maloney Notary Public.

15-163-20081-00-00

DRILLERS LOG

Pywell No. 2

CASING RECORD: 8 5/8" @ 227.09' w/165 sx cement  
 COMPANY: White & Ellis Drilling Co.  
 CONTRACTOR: Red Tiger Drilling Co.  
 COMMENCED: December 15, 1967  
 COMPLETED: December 22, 1967  
 TOTAL DEPTH: 3819'  
 DESCRIPTION: NW SE SE 36-9S-20W Rocks Co., Ks.  
 ELEVATION:

<u>FORMATION</u>	<u>FROM</u>	<u>TO</u>	<u>REMARKS</u>
Clay & Sand	0	45	
Shale	45	700	
Sand & Shale	700	1030	
Shale	1030	1135	
Sand	1135	1330	
Shale Shells	1330	1655	
Anhydrite	1655	1698	
Shale & Shells	1698	2270	
Shale w/lime	2270	3412	
Lime	3412	3819	

I certify that this is a true and correct copy of the above log to the best of my knowledge.

RED TIGER DRILLING COMPANY

*George A. Boyle*

Subscribed and sworn to before me this 26th day of December, 1967.

*Betty M. Maloney*  
Notary Public

My Commission Expires:  
3-22-71

RECEIVED  
STATE CORPORATION COMMISSION  
JAN 9 1968  
CONSERVATION DIVISION  
Wichita, Kansas