

CARD MUST BE TYPED

State of Kansas

CARD MUST BE SIGNED

NOTICE OF INTENTION TO DRILL

(see rules on reverse side)

Expected Spud Date..... 11 8 1987
month day year

API Number 15— 099-22,627-00-00

OPERATOR: License #..... 4870
Name..... THOMAS A. LAUTH
Address..... 524 N. Penn. #106
City/State/Zip..... Independence, Kans. 67301
Contact Person..... Thomas Lauth
Phone..... (316) 331-6544

NE. SW. NE. Sec... 35. Twp... 34 S, Rg... 20. East
3320 _____ Ft. from South Line of Section
1950 _____ Ft. from East Line of Section

(Note: Locate well on Section Plat on reverse side)

CONTRACTOR: License #..... 3328
Name..... Central States Oil & Gas.
City/State..... Cherryvale, Kans. 67335

Nearest lease or unit boundary line 630 feet
County... LABETTE

Well Drilled For: Well Class: Type Equipment:
 Oil _____ Storage _____ Infield _____ Mud Rotary
_____ Gas _____ Inj _____ Pool Ext. _____ Air Rotary
_____ OWWO _____ Expl Wildcat _____ Cable

Lease Name..... BOGLE Well #... JL-5
Ground surface elevation feet MSL

If OWWO: old well info as follows:

Operator
Well Name
Comp Date..... Old Total Depth.....

Domestic well within 330 feet: _____ yes no
Municipal well within one mile: _____ yes no

Depth to bottom of fresh water..... 20

Depth to bottom of usable water..... 100

Surface pipe by Alternate: 1 _____ 2

Surface pipe planned to be set 20

Conductor pipe required None

Projected Total Depth 830 feet

Formation..... Arbuckle

I certify that well will comply with K.S.A. 55-101, et seq., plus eventually plugging holes to KCC specifications.

Date 11-3-87 Signature of Operator or Agent *Frank [Signature]* Title _____ Agent _____

For KCC Use:

Conductor Pipe Required feet; Minimum Surface Pipe Required 20 feet per Alt. 1

This Authorization Expires 6-4-88 Approved By *[Signature]* 11-4-87


EFFECTIVE DATE: 11-9-87

Must be filed with the K.C.C. five (5) days prior to commencing well
This card void if drilling not started within six (6) months of date received by K.C.C.

Important procedures to follow:

1. Notify District office before setting surface casing.
2. Set surface casing by circulating cement to the top.
3. File completion forms ACO-1 with K.C.C. within 120 days of well spud date, following instructions on ACO-1, side 1, and including copies of wireline logs.
4. Notify District office 48 hours prior to old well workover or re-entry.
5. Prior to filing Intent, prepare a proposed plugging plan in case well is D & A, then obtain approval of plan when calling district office prior to setting surface pipe.
6. Submit plugging report (CP-4) to K.C.C. after plugging is completed.
7. Obtain an approved injection docket number before disposing of salt water.
8. Notify K.C.C. within 10 days when injection commences or terminates.
9. If an alternate 2 completion, cement in the production pipe from below any usable water to surface within 120 days of spud date.

**A Regular Section of Land
1 Mile = 5,280 Ft.**

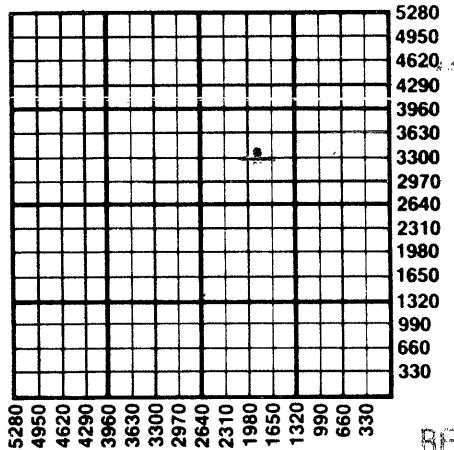

RECEIVED
STATE CORPORATION COMMISSION

NOV 4 1987

CONSERVATION DIVISION
Wichita, Kansas

State Corporation Commission of Kansas
Conservation Division
200 Colorado Derby Building
Wichita, Kansas 67202-1212
(316) 263-3238

11-4-87