

CARD MUST BE TYPED

State of Kansas

CARD MUST BE SIGNED

NOTICE OF INTENTION TO DRILL

(see rules on reverse side)

Starting Date 10-3-85
month day year

API Number 15- 065-22,245-0000

OPERATOR: License # 6393
Name BROUGHER OIL, INC
Address P. O. Drawer 1367
City/State/Zip Great Bend, KS 67530
Contact Person Joe E. Brougher
Phone 316-793-5610

NW. NE. SW. Sec. 4 Twp. 9 S, Rg. 21 X West
2310
3630
..... Ft. from South Line of Section
..... Ft. from East Line of Section

(Note: Locate well on Section Plat on reverse side)

CONTRACTOR: License # 6394
Name MOHAWK DRILLING, INC.
City/State Great Bend, Kansas

Nearest lease or unit boundary line 990 East feet
County Graham

Well Drilled For: Well Class: Type Equipment:
 Oil SWD Infield Mud Rotary
 Gas Inj Pool Ext. Air Rotary
 OWWO Expl Wildcat Cable

Lease Name NAPUE Well # 4
Ground surface elevation Unknown feet MSL

If OWWO: old well info as follows:

Operator
Well Name
Comp Date Old Total Depth

Domestic well within 330 feet: yes no
Municipal well within one mile: yes no
Surface pipe by Alternate: 1 ~~2~~
Depth to bottom of fresh water 150
Depth to bottom of usable water 900
Surface pipe planned to be set 300
Projected Total Depth 3800 feet
Formation Arbuckle

I certify that well will comply with K.S.A. 55-101, et seq., plus eventually plugging hole to KCC specifications.

Yes cementing will be done immediately upon setting production casing.
Date .. 10/1/85 Signature of Operator or Agent *Joe E. Brougher* Title President

For KCC Use:

Conductor Pipe Required feet: Minimum Surface Pipe Required feet per Alt 1 2
This Authorization Expires 4-2-86 Approved By *10-2-85*

Must be filed with the K.C.C. five (5) days prior to commencing well
This card void if drilling not started within six (6) months of date received by K.C.C.


Important procedures to follow:

RECEIVED
STATE CORPORATION COMMISSION

10/2/85
OCT 2 1985

**A Regular Section of Land
1 Mile = 5,280 Ft.**

CONSERVATION DIVISION
Wichita, Kansas

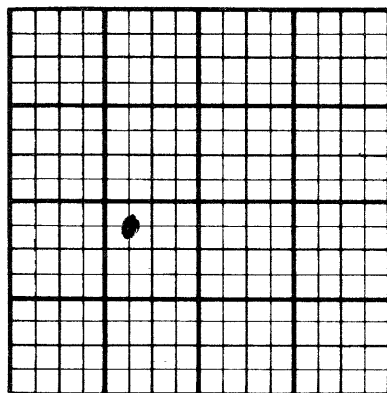

5280
4950
4620
4290
3960
3630
3300
2970
2640
2310
1980
1650
1320
990
660
330

1. Notify District office before setting surface casing.
2. Set surface casing by circulating cement to the top.
3. File completion forms ACO-1 with K.C.C. within 90 days of well completion, following instructions on ACO-1, side 1, and including copies of wireline logs.
4. Notify District office 48 hours prior to old well workover or re-entry.
5. Prior to filing Intent, prepare a proposed plugging plan in case well is D & A, then obtain approval of plan when calling district office prior to setting surface pipe.
6. Submit plugging report (CP-4) to K.C.C. after plugging is completed.
7. Obtain an approved injection docket number before disposing of salt water.
8. Notify K.C.C. within 10 days when injection commences or terminates.
9. If an alternate 2 completion, cement in the production pipe from below any usable water to surface within 120 days of spud date.

State Corporation Commission of Kansas
Conservation Division
200 Colorado Derby Building
Wichita, Kansas 67202
(316) 263-3238