

CARD MUST BE TYPED

State of Kansas NOTICE OF INTENTION TO DRILL

CARD MUST BE SIGNED

(see rules on reverse side)

Starting Date: 9 15 84
month day year

API Number 15- 065-22,067-0000

OPERATOR: License # 6393
Name Brougher Oil, Inc.
Address P. O. Drawer 1367
City/State/Zip Great Bend, KS 67530
Contact Person Joe E. Brougher
Phone 316-793-5610

NW SW SE Sec 4 Twp 9 S, Rge 21
(location) East West

990
2310 Ft North from Southeast Corner of Section
..... Ft West from Southeast Corner of Section
(Note: Locate well on Section Plat on reverse side)

CONTRACTOR: License # 6394
Name Mohawk Drilling, Inc.
City/State Great Bend, Kansas

Nearest lease or unit boundary line 330' west feet.
County Graham

Lease Name Hedge Well# 1

Domestic well within 330 feet : yes no

Municipal well within one mile : yes no

Well Drilled For: Well Class: Type Equipment:
 Oil Swd Infield Mud Rotary
 Gas Inj Pool Ext. Air Rotary
 OWWO Expl Wildcat Cable

Depth to Bottom of fresh water 150 feet

Lowest usable water formation Dakota

Depth to Bottom of usable water ~~Unknown~~ 700 feet

Surface pipe by Alternate : 1 2

Surface pipe to be set 300 feet

Conductor pipe if any required None feet

Ground surface elevation Unknown feet MSL

This Authorization Expires 3-6-85

Approved By J. E. Brougher RC

If OWWO: old well info as follows:

Operator
Well Name
Comp Date Old Total Depth
Projected Total Depth 3800 feet
Projected Formation at TD 3750
Expected Producing Formations Arbuckle

I certify that we will comply with K.S.A. 55-101, et seq., plus eventually plugging hole to K.C.C. specifications.

Date 9-5-84 Signature of Operator or Agent Joe E. Brougher Title


President

MHC/NOHE 9/6/84

Must be filed with the K.C.C. five (5) days prior to commencing well
 This card void if drilling not started within six (6) months of date received by K.C.C.

Important procedures to follow :

A Regular Section of Land
1 Mile = 5,280 Ft.

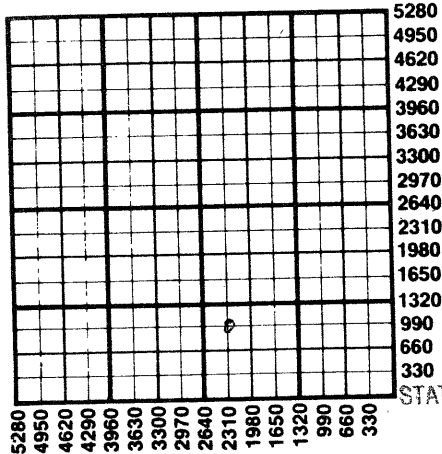

1. Notify District office before setting surface casing.
2. Set surface casing by circulating cement to the top.
3. File completion forms ACO-1 with K.C.C. within 90 days of well completion, following instructions on ACO-1, side 1, and including copies of wireline logs.
4. Notify District office 48 hours prior to old well workover or re-entry.
5. Prior to plugging, prepare a plugging plan, then obtain agreement from the appropriate district office for an approved plugging plan.
6. Submit plugging report (CP-4) to K.C.C. after plugging is completed.
7. Obtain an approved injection docket number before disposing of salt water.
8. Notify K.C.C. within 10 days when injection commences or terminates.
9. If an alternate 2 completion, cement in the production pipe from below any usable water to surface within 120 days of spud date.

RECEIVED
 STATE CORPORATION COMMISSION
 9/6/84

SEP 06 1984

CONSERVATION DIVISION
 Wichita, Kansas

State Corporation Commission of Kansas
 Conservation Division
 200 Colorado Derby Building
 Wichita, Kansas 67202
 (316) 263-3238