

STATE OF KANSAS
CORPORATION COMMISSION


WELL PLUGGING RECORD

Give All Information Completely
Make Required Affidavit
Mail or Deliver Report to:
Conservation Division
State Corporation Commission
800 Bitting Building
Wichita, Kansas

Rooks County, Sec. 36 Twp. 9 Rge. 20 ~~XXXXX~~ (W)

Location as "NE/CNW/SW" or footage from lines SW NW NE
Lease Owner K & E Drilling, Inc. & Oil Trading Assoc., Inc.
Lease Name Steeples "c" Well No. 1
Office Address 1006 Central Bldg., Wichita, Kansas
Character of Well (completed as Oil, Gas or Dry Hole) dry hole
Date well completed April 16, 1955
Application for plugging filed April 16, 1955
Application for plugging approved April 16, 1955
Plugging commenced April 17, 1955
Plugging completed April 17, 1955
Reason for abandonment of well or producing formation
commercial quantities of oil not found
If a producing well is abandoned, date of last production 19
Was permission obtained from the Conservation Division or its agents before plugging was commenced? yes

NORTH

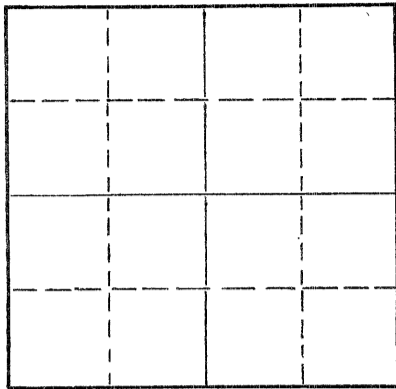

Locate well correctly on above Section Plat

Name of Conservation Agent who supervised plugging of this well Eldon Petty, Box 326, Hays, Kansas
Producing formation _____ Depth to top _____ Bottom _____ Total Depth of Well _____ Feet
Show depth and thickness of all water, oil and gas formations.

OIL, GAS OR WATER RECORDS

CASING RECORD

FORMATION	CONTENT	FROM	TO	SIZE	PUT IN	PULLED OUT
				8 5/8	221'	none

Describe in detail the manner in which the well was plugged, indicating where the mud fluid was placed and the method or methods used in introducing it into the hole. If cement or other plugs were used, state the character of same and depth placed, from _____ feet to _____ feet for each plug set.

Filled hole with heavy mud from 3850' to 221'. Set wooden plug with 15 sacks cement. Second plug at 40' and capped with 10 sacks cement.

RE
STATE CODE
4/22/55
APR 22 1955
CONSERVATION DIVISION
Wichita, Kansas

(If additional description is necessary, use BACK of this sheet)

Name of Plugging Contractor K & E DRILLING, INC.
Address 1006 Central Bldg., Wichita, Kansas


STATE OF Kansas, COUNTY OF Sedgwick, ss.
Dale Silcott (employee of owner) of the above-described well, being first duly sworn on oath, says: That I have knowledge of the facts, statements, and matters herein contained and the log of the above-described well as filed and that the same are true and correct. So help me God.

(Signature) Dale Silcott
1006 Central Bldg., Wichita, Kansas
(Address)

SUBSCRIBED AND SWORN TO before me this 21st day of April, 1955

Francis Mueller
Notary Public.

My commission expires June 25, 1956

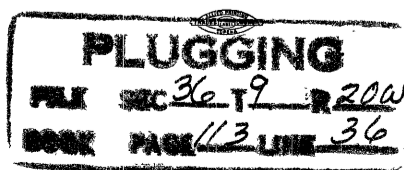

15-163-00881-00-00

OIL TRADING ASSOCIATES, INC. &
K & E DRILLING, INC.
Steeple "C" #1

SW NW NE Section 36-9S-20W
Rooks County, Kansas

Comm: 4-8-55
Comp: 4-16-55
Total Depth: 3850'

Casing

8 5/8 Set @ 221'

Cement

140 sacks

FORMATION

DEPTH

Surface clay & sand	0 - 65
Sand & shale	65 - 221
Shale & shells	221 - 910
Sand & shale	910 - 1130
Sand	1130 - 1395
Shale & sand	1395 - 1530
Red bed & shale	1530 - 1667
Anhydrite	1667 - 1710
Anhydrite - lime	1710 - 1745
Shale & shells	1745 - 2175
Lime & shale	2175 - 2460
Sand & lime	2460 - 2550
Lime & shale	2550 - 3165
Shale & shells	3165 - 3260
Lime & shale	3260 - 3385
Lime	3385 - 3460
Shale	3460 - 3467
Heebner	3467
Lime	3467 - 3510
Lime	3510 - 3703
Lime & shale	3703 - 3770
Conglomerate	3770 - 3838
Conglomerate - chert	3838 - 3850

STATE OF KANSAS)
) SS
SEDGWICK COUNTY)

I hereby certify that the above information is true and correct to the best of my knowledge.

Ralph Elliott

Subscribed and sworn to before me this 21st day of April, 1955

My Commission expires: June 25, 1956

Francis Charles
Notary Public

PLUGGING

RECEIVED
CONSOLIDATED OIL FIELD SERVICE